

DIKE
E35
7-67 COVERED

MISSISSIPPI
BOARD OF WATER COMMISSIONERS
416 North State Street
Jackson, Mississippi 39201

WATER WELL DRILLERS LOG

7-19-67 date well completed
27 Fitzgerald Water Well pipe firm name
Miss county well located


LANDOWNER: Winfred McComb
Rt 1 - McComb, Miss
(mailing address)

description of formations encountered	from	to
top soil	0	35
Red Sand	35	100
gravel		

WELL LOCATION:
sec 29 T 3 N R 8 E
S W
2 miles NE of Fernwood
(distance) (direction) (nearest town)

WELL PURPOSE: home
(home, irrigation, municipal, industrial)


- WELL COMPLETION DATA:
- (1) diameter (inches) 4
 - (2) total depth (feet) 100
 - (3) static water level (feet) 10 below top of ground
 - (4) casing plastic 94 (material) (depth)
 - 4 (size) if telescope see back.
 - (5) screen 6' 94 (length) (depth to top)
 - 4 plastic (size) (material)
 - (6) pump (HP) (yield gpm)
 - (type power)
 - (7) electric log No (yes or no)
 - (organization running log)
 - (8) how well bottom plugged Wood peg

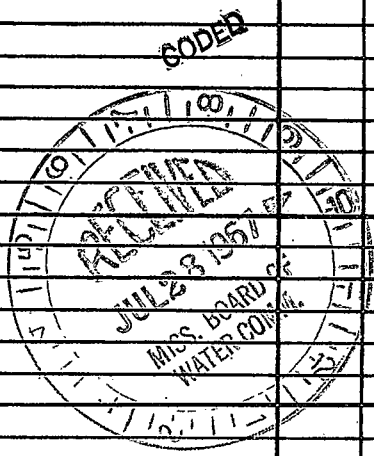

DRILLERS REMARKS:

If well telescopes please sketch and show depths.

GROUND LEVEL

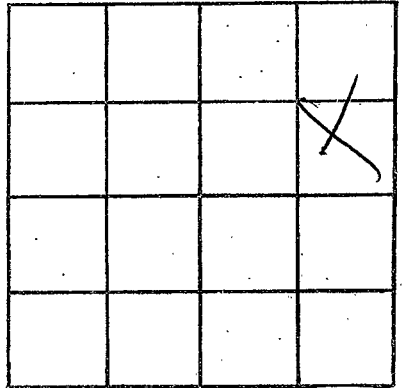

SECTION 29

Please indicate well location X.

ADDITIONAL INFORMATION

If more than one screen, show locations of each on sketch.