

**MISSISSIPPI
BOARD OF WATER COMMISSIONERS**
416 North State Street
Jackson, Mississippi 39201

WATER WELL DRILLERS LOG

Pike
E36 CODED
9-67

Sept 16 19*67* *Reverwell Pump* *Pike*
date well completed firm name county well located

LANDOWNER: *Ernest Matthews*
RTD-McComb
(mailing address)

WELL LOCATION:
sec *34* T *3* N R *8* E
6 miles *SE* *McComb*
(distance) (direction) (nearest town)

WELL PURPOSE: *Home*
(home, irrigation, municipal, industrial)

WELL COMPLETION DATA:

(1) diameter (inches) *4"*

(2) total depth (feet) *118*

(3) static water level (feet) *9.5* below above top of ground.

(4) casing *Plastic Ballans*
(material) (depth)

(size) if telescope see back.

(5) screen *6'* *112'*
(length) (depth to top)
4" *Plastic*
(size) (material)

(6) pump *Sub* *12*
(HP) (yield gpm)
Elect
(type power)


(7) electric log *NO*
(yes or no)

(organization running log)

description of formations encountered	from	to
<i>Red clay</i>	<i>0</i>	<i>30</i>
<i>Red sand</i>	<i>30</i>	<i>60</i>
<i>gravel & sand</i>	<i>60</i>	<i>72</i>
<i>fine sandy clay</i>	<i>72</i>	<i>105</i>
<i>small gravel sand</i>	<i>105</i>	<i>118</i>


(8) how well bottom plugged
wooden plug

DRILLERS REMARKS:
New house.

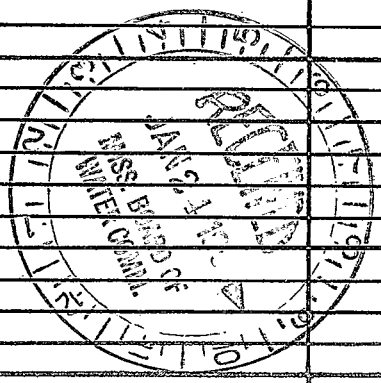

If well telescopes please sketch and show depths.

GROUND LEVEL

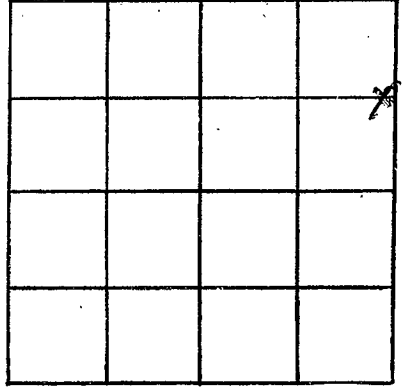

SECTION 34

Please indicate well location X.

ADDITIONAL INFORMATION

If more than one screen, show locations of each on sketch.