

Pike
E 37
10-67

MISSISSIPPI
BOARD OF WATER COMMISSIONERS
416 North State Street
Jackson, Mississippi 39201

WATER WELL DRILLERS LOG

10-24 date well completed 1967 firm name W. H. Leonard & Sons Well Drilling & Service county well located Pike

LANDOWNER: Rodney Bates
McLomb MISS
(mailing address)

description of formations encountered	from	to
Top soil & clay	0	16
Red sand	16	68
Heavy gravel	68	87
Red chalk	87	98
Sand & gravel	90	98
Red chalk	98	102
Fine sand	102	125
Orange sands gravel	125	146


WELL LOCATION:
sec. 17 T. 3 N. R. 8 E S. 3 miles E of McLomb
(distance) (direction) (nearest town)

WELL PURPOSE: home
(home, irrigation, municipal, industrial)

WELL COMPLETION DATA:
(1) diameter (inches) 4
(2) total depth (feet) 136
(3) static water level (feet) 9 below top of ground.
(4) casing plastic 128 (material) (depth)
(size) 4 if telescope see back.
(5) screen 6' 128 (length) (depth to top)
(size) 4 plastic (material)
(6) pump 1/2 (HP) 8 (yield gpm)
(type power) electric
(7) electric log No (yes or no)

(organization running log)
(8) how well bottom plugged


DRILLERS REMARKS:

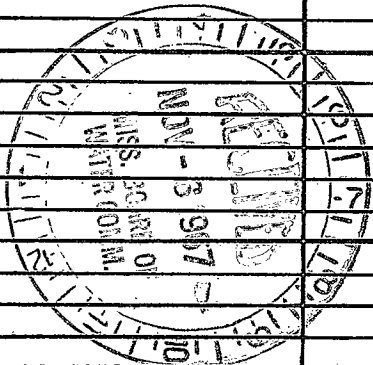

CODED

If well telescopes please sketch and show depths.

GROUND LEVEL

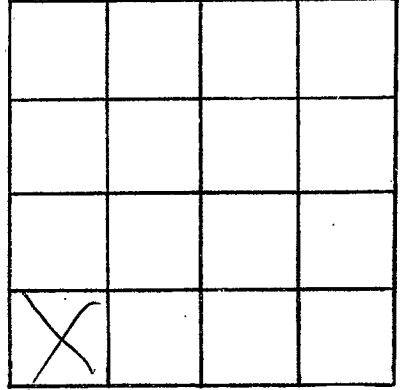

SECTION 117

Please indicate well location X.

ADDITIONAL INFORMATION

If more than one screen, show locations of each on sketch.