

Oike  
E38  
12-67

CODED

MISSISSIPPI  
BOARD OF WATER COMMISSIONERS  
416 North State Street  
Jackson, Mississippi 39201

WATER WELL DRILLERS LOG

12-14 1967 Hegerard Water Well pike  
date well completed firm name county well located

LANDOWNER: Dickerson & Barry  
McComb Miss  
(mailing address)

description of formations encountered	from	to
<u>top soil &amp; clay</u>	<u>0</u>	<u>12</u>
<u>Red sand</u>	<u>12</u>	<u>30</u>
<u>gravel &amp; sand</u>	<u>30</u>	<u>133</u>


WELL LOCATION:  
sec. 17 T. 3 N. R. 8 E.  
2 miles E of McComb  
(distance) (direction) (nearest town)

WELL PURPOSE: House trailer  
(home, irrigation, municipal, industrial)

WELL COMPLETION DATA:

- (1) diameter (inches) 2
- (2) total depth (feet) 133
- (3) static water level (feet) 115 below top of ground.
- (4) casing 2" galv, 127  
(material) (depth)  
(size) if telescope see back.
- (5) screen 6, 127  
(length) (depth to top)  
1 1/2" x 6" Stainless  
(size) (material)
- (6) pump 1 Jet 5  
(HP) (yield gpm)  
Elec  
(type power)
- (7) electric log NO  
(yes or no)  
(organization running log)
- (8) how well bottom plugged


CODED

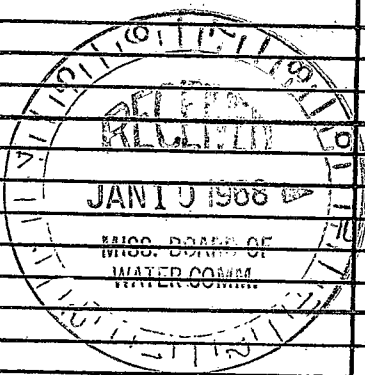

DRILLERS REMARKS:

If well telescopes please sketch and show depths.

GROUND LEVEL

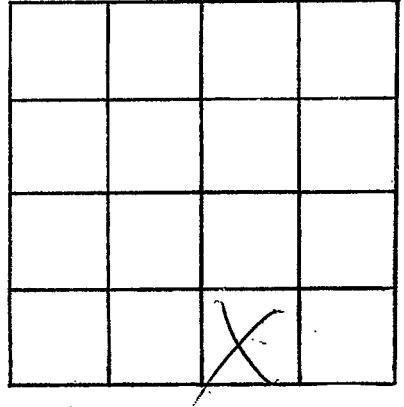

SECTION 17

Please indicate well location X.

ADDITIONAL INFORMATION

If more than one screen,  
show locations of each on sketch.