

**MISSISSIPPI
BOARD OF WATER COMMISSIONERS
416 North State Street
Jackson, Mississippi 39201**

WATER WELL DRILLERS LOG

Pike
E39
12-67

Dec 30 19*68* *Keeneswell Drilling Co. Pike*
date well completed firm name county well located

LANDOWNER: *Zuma Jackson*

*Rt-1,
M. Camb.*
(mailing address)

WELL LOCATION:

sec. *32* T *3* N R *8* E
1 1/4 miles *SE* of *Terrebonne*
(distance) (direction) (nearest town)

WELL PURPOSE: *Home*
(home, irrigation, municipal, industrial)

WELL COMPLETION DATA:

(1) diameter (inches) *4"*
(2) total depth (feet) *105*

(3) static water level (feet) *81* below above top of ground

(4) casing *Plastic bottom*
(material) (depth)

(size) if telescope see back.

(5) screen *6'* *99'*
(length) (depth to top)

1/2" *Plastic*
(size) (material)

(6) pump *1/2 Sub* *1 1/2"*
(HP) (yield gpm)

Elect
(type power)


(7) electric log *No*
(yes or no)

(organization running log)

(8) how well bottom plugged
wooden plug


DRILLERS REMARKS:
*old well
Bad.*

description of formations encountered	from	to
<i>Red clay</i>	<i>0</i>	<i>17</i>
<i>Red Sand</i>	<i>17</i>	<i>74</i>
<i>Gravel</i>	<i>74</i>	<i>88</i>
<i>Sandy Red sand</i>	<i>88</i>	<i>95</i>
<i>Red gravel and sandy sand</i>	<i>95</i>	<i>105</i>

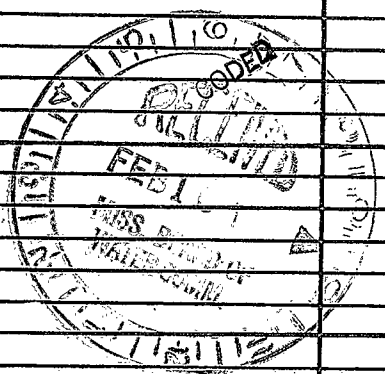

If well telescopes please sketch and show depths.

GROUND LEVEL

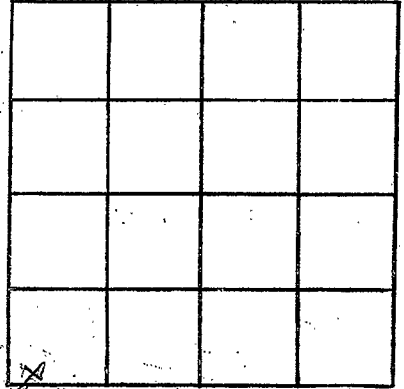

SECTION 32

Please indicate well location X.

ADDITIONAL INFORMATION

If more than one screen,
show locations of each on sketch.