

PIKE
E40
2-68

CODED

MISSISSIPPI
BOARD OF WATER COMMISSIONERS
416 North State Street
Jackson, Mississippi 39201

WATER WELL DRILLERS LOG

Feb 27 1968 Rever Well Drilling Co Pike
date well completed firm name county well located

LANDOWNER: Mrs. C. B. Simmons
RFD 1, Magnolia
(mailing address)

description of formations encountered	from	to
Red clay	0	18
pink chalk	18	146
Red sand	46	109
Small gravel sand	109	109
Sand Rock	109	110
Mixed chalk & sand	110	147
small gravel	147	150

WELL LOCATION:
sec. 9 T. 3 N. R. 6 E
3 miles SE Magnolia
(distance) (direction) (nearest town)

WELL PURPOSE: farm
(home, irrigation, municipal, industrial)


WELL COMPLETION DATA:

- (1) diameter (inches) 4"
- (2) total depth (feet) 150
- (3) static water level (feet) 106 below top of ground.
- (4) casing plaster bottom
(material) (depth)
(size) if telescope see back.
- (5) screen 6 144
(length) (depth to top)
4" plastic
(size) (material)
- (6) pump rod pump
(type power) (yield gpm)
- (7) electric log no
(yes or no)
(organization running log)

(8) how well bottom plugged wooden plug


DRILLERS REMARKS:
old 4" steel well cap

CODED

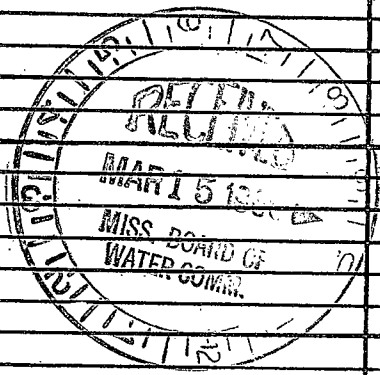

If well telescopes please sketch and show depths.

GROUND LEVEL

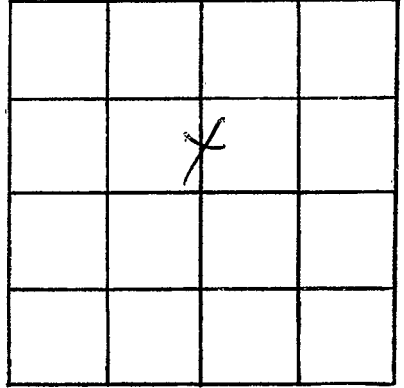

SECTION 9

Please indicate well location X.

ADDITIONAL INFORMATION

If more than one screen,
show locations of each on sketch.