

PIKE
E41 ~~CODER~~
368

MISSISSIPPI
BOARD OF WATER COMMISSIONERS
416 North State Street
Jackson, Mississippi 39201

WATER WELL DRILLERS LOG

3-20-68 date well completed
W. Stegowski firm name
Pike county well located

LANDOWNERS: Louis Gardner
Rt 1 McComb MS (mailing address)


description of formations encountered	from	to
Topsoil & Clay	0	12
Red sand	12	65
Sandy gravel	65	85
Sand	85	130
Coarse Sand Gravel	130	140

WELL LOCATION:
sec 22 T 3 N R 8 E
S W
5 miles E McComb (distance) (direction) (nearest town)

WELL PURPOSE: home (home, irrigation, municipal, industrial)

- WELL COMPLETION DATA:
- (1) diameter (inches) 4
 - (2) total depth (feet) 140
 - (3) static water level (feet) 10 below top of ground.
 - (4) casing plastic 136 (material) (depth)
 - 4 (size) if telescope see back.
 - (5) screen 6' 136 (length) (depth to top)
 - 4 Sch 40 (size) (material)
 - (6) pump 1/2 HP 10 (HP) (yield gpm)
 - Elec (type power)
 - (7) electric log yes (yes or no)
 - (organization running log)
 - (8) how well bottom plugged Wood Peg


CODER

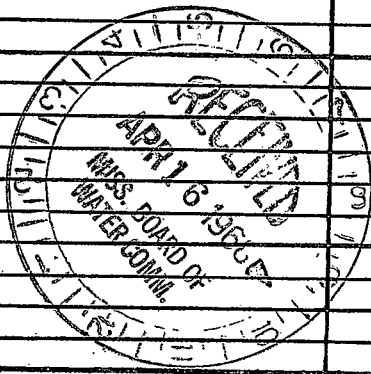

DRILLERS REMARKS:

If well telescopes please sketch and show depths.

GROUND LEVEL

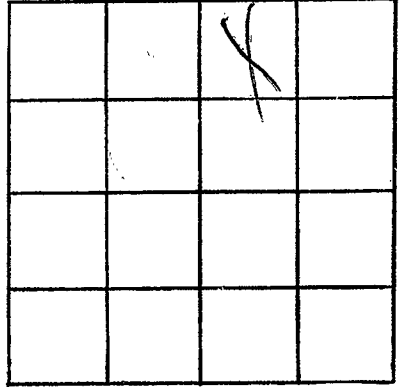

SECTION 22

Please indicate well location X.

ADDITIONAL INFORMATION

If more than one screen, show locations of each on sketch.