

**MISSISSIPPI  
BOARD OF WATER COMMISSIONERS  
416 North State Street  
Jackson, Mississippi 39201**

**WATER WELL DRILLERS LOG**

*Pike*  
E42  
7-68 **CODED**

July 13 1968 *Kennerwell Pump* *Pike*  
date well completed firm name county well located

LANDOWNER: *C. S. Montgomery*  
*RT-1, McComb*  
(mailing address)

description of formations encountered	from	to
<i>Red Clay</i>	<i>0</i>	<i>27</i>
<i>Red sandy chalk</i>	<i>27</i>	<i>70</i>
<i>Red chalk</i>	<i>70</i>	<i>85</i>
<i>sandy gravel</i>	<i>85</i>	<i>120</i>
<i>coarse sand &amp; pea gravel</i>	<i>120</i>	<i>131</i>

WELL LOCATION:  
sec. *28* T. *3* N. R. *6* E  
*3* miles *SE* of *McComb*  
(distance) (direction) (nearest town)

WELL PURPOSE: *thermal*  
(home, irrigation, municipal, industrial)

**WELL COMPLETION DATA:**


- (1) diameter (inches) *4"*
- (2) total depth (feet) *131*
- (3) static water level (feet) *91* below top of ground.
- (4) casing *plastic Ballows*  
(material) (depth)
- (5) screen *6' 125'*  
(length) (depth to top)  
*4" plastic*  
(size) (material)
- (6) pump *red Kennerwell*  
(HP) (yield gpm)  
*3/4 HP*  
(type power)
- (7) electric log *no*  
(yes or no)
- (organization running log)
- (8) how well bottom plugged *wooden plug*

DRILLERS REMARKS:  
*red well bad*

**CODED**  
MUL 1 P 1058  
JUL 19 1968

If well telescopes please  
sketch and show depths.

GROUND LEVEL

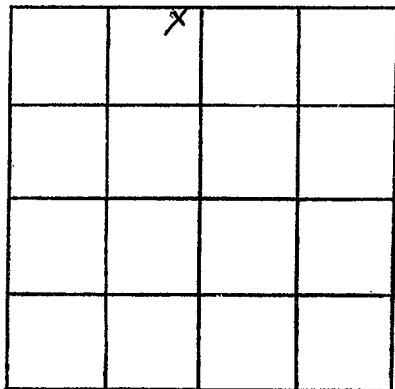

SECTION 28

Please indicate well location X.

ADDITIONAL INFORMATION

If more than one screen,  
show locations of each on sketch.