

**MISSISSIPPI
BOARD OF WATER COMMISSIONERS**
416 North State Street
Jackson, Mississippi 39201

WATER WELL DRILLERS LOG

Pike
E 43
5-68 **CODED**

May 22 1968 *Beverswell Pump* **Pike**
date well completed firm name county well located

LANDOWNER: *Daniel Oliver*
H. I. McLamb
(mailing address)

WELL LOCATION:
sec. *31* T *3* N R *8* E
1 1/2 miles *SE* of *Farmwood*
(distance) (direction) (nearest town)

WELL PURPOSE: *farm*
(home, irrigation, municipal, industrial)

WELL COMPLETION DATA:
(1) diameter (inches) *4"*
(2) total depth (feet) *118*
(3) static water level (feet) *85* below above top of ground.
(4) casing *Plastic* *Bottom*
(material) (depth)

(size) if telescope see back.
(5) screen *6'* *107*
(length) (depth to top)
4" *Plastic*
(size) (material)

(6) pump *3/4 HP* *8*
(HP) (yield gpm)
Electric
(type power)

(7) electric log *NO*
(yes or no)

(organization running log)

(8) how well bottom plugged
woodchip plug

DRILLERS REMARKS:
New Bore


description of formations encountered	from	to
<i>clay & sand</i>	<i>0</i>	<i>2.5</i>
<i>Red sand & gravel</i>	<i>2.5</i>	<i>60</i>
<i>clay & gravel</i>	<i>60</i>	<i>100</i>
<i>Subsided gravel</i>	<i>100</i>	<i>118</i>

CODED

MAILED 7 1968
MISS. BOARD OF WATER COMMISSIONERS

If well telescopes please sketch and show depths.

GROUND LEVEL

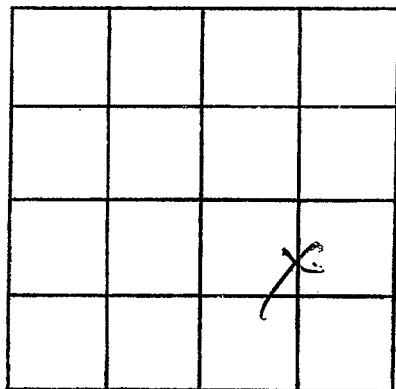

SECTION 31

Please indicate well location X.

ADDITIONAL INFORMATION

If more than one screen, show locations of each on sketch.