

PIKE
E 44
5-4-63

MISSISSIPPI BOARD OF WATER COMMISSIONERS

CODED

WATER WELL DRILLERS LOG

Date: 5-4 ^{CODED} 1963, Driller: Chester Reeves County Wade

(Name)

(1) Owner of Land: (Name) <u>B. L. Welch</u> <u>M. Lamb - Rt. 2</u> (Address)	Description & Color of Materials Sand, Clay, Red Clay, Shell, etc.	Thick- ness Feet	De p th
	<u>Red clay</u>	<u>20</u>	<u>20</u>
	<u>Red sand</u>	<u>88</u>	<u>108</u>
	<u>Blue chalk</u>	<u>82</u>	<u>190</u>
	<u>fine sand</u>	<u>10</u>	<u>200</u>

(2) Location: 1/4, 5 1/4 Sec. 8 T 3 R 8,
2 miles EAST of M. Lamb
(distance) (direction) (Nearest Town)

(3) Topography: Hilly
(Hilly) (Flat) (Level)

(4) Purpose of Well: Domestic
(Domestic Irrigation
Municipal, Industrial, Other)

Information upon completion of well:


- (1) Diameter 4 inches.
- (2) Total Depth 200 feet.
- (3) Water Level 108 feet below top of ground.
- (4) Cased to bottom size 4.
- (5) Screen: Size 4", Length 8'.

(6) Were any formations sealed against pollution?
_____ yes, no.

If YES depth of formation _____

Why _____

Drillers Remarks: New House

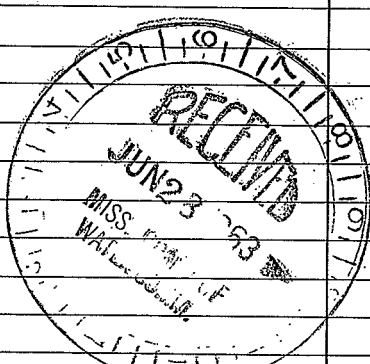

CODED

REEVES WELL & PUMP CO.
P. O. BOX 71 - PHONE 684-1441
McCOMB, MISS.

(Use Back Side)

Well No.

