

MISSISSIPPI
BOARD OF WATER COMMISSIONERS
416 North State Street
Jackson, Mississippi 39201

CODED

WATER WELL DRILLERS LOG

PIKE
E48
4-22-71

April 22 1971 Chester Keene P. Keene
date well completed firm name county well located

LANDOWNER: Mrs. Geo. Phelps
H-1, M. Lamb.
(mailing address)

description of formations encountered	from	to
clay	0	17
white sand	17	64
small pebbles clay	64	87

WELL LOCATION:
sec. 28 T. 3 N R. 6 E
4 miles SE M. Lamb
(distance) (direction) (nearest town)

WELL PURPOSE: Home
(home, irrigation, municipal, industrial)

- WELL COMPLETION DATA:
- (1) diameter (inches) 4"
 - (2) total depth (feet) 87
 - (3) static water level (feet) 67 below top of ground.
 - (4) casing plastic ball joint
(material) (depth)
(size) if telescope see back.
 - (5) screen 6' 8'
(length) (depth to top)
4" plastic
(size) (material)
 - (6) pump run by others
(HP) (yield gpm)
(type power)
 - (7) electric log NO
(yes or no)
(organization running log)
 - (8) how well bottom plugged wooden plug

CODED


DRILLERS REMARKS:
old well had

MAY 20 1971

MISS. DEPT. OF
WATER CONTROL

If well telescopes please sketch and show depths.

GROUND LEVEL

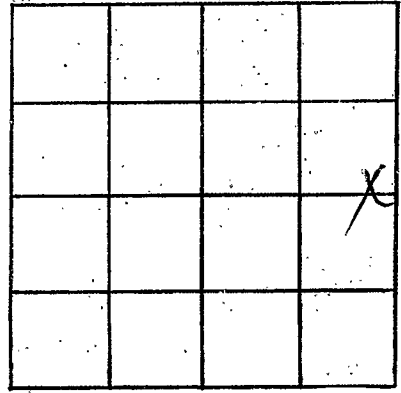

SECTION 28

Please indicate well location X.

ADDITIONAL INFORMATION

A series of horizontal lines for writing additional information, starting below the 'ADDITIONAL INFORMATION' header and extending to the bottom of the page.

If more than one screen, show locations of each on sketch.