

PIKE  
E49  
8-18-64

MISSISSIPPI BOARD OF WATER COMMISSIONERS  
CODED  
CODED  
CODED

MISSISSIPPI BOARD OF WATER COMMISSIONERS

WATER WELL DRILLERS LOG CODED

Date: 8-18, 1964, Driller: Chester Lewis County Pike  
(Name)

(1) Owner of Land: South Pike School Board  
(Name)  
Magnolia  
(Address)  
P.H. Shacks Center  
(2) Location: 1/4, 1/4, Sec. 3 T. 3R. 8  
1 miles east of Fannwood  
(distance) (direction) (Nearest Town)  
(3) Topography: flat  
(Hilly) (Flat) (Level)  
(4) Purpose of Well: School  
(Domestic Irrigation  
Municipal, Industrial, Other)


Description & Color of Materials Sand, Clay, Red Clay, Shell, etc.	Thick- ness Feet	Depth Feet
<u>Top Soil</u>	<u>8</u>	<u>8</u>
<u>Sand &amp; gravel</u>	<u>47</u>	<u>55</u>

Information upon completion of well:

- (1) Diameter 4 inches.
- (2) Total Depth 55 feet.
- (3) Water Level 18 feet below top of ground.
- (4) Cased to bellows size 4".
- (5) Screen: Size 4", Length 20'.
- (6) Were any formations sealed against pollution?  
✓ yes, ○ no.

Location category 5

CODED

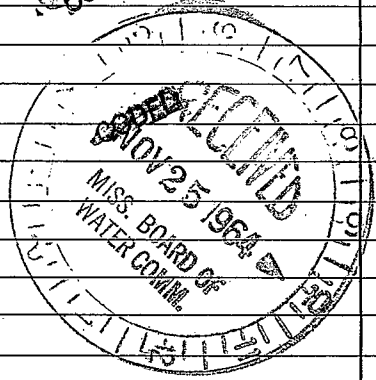

If YES depth of formation Surface  
Why Required

Drillers Remarks:  
old well bad.

REEVES WELL & PUMP CO.  
P. O. BOX 71 -- PHONE 684-1451  
McCOMB, MISS.

(Use Back Side)

Well No.

1000

1000

1000