

PIKE
E 51
3-12-71

MISSISSIPPI
BOARD OF WATER COMMISSIONERS
416 North State Street
Jackson, Mississippi 39201

CODED

WATER WELL DRILLERS LOG

12 March 1971 *Spr Water Well* *Pike*
date well completed firm name county well located

LANDOWNER:
Eggs R. Bowman
McComb
(mailing address)

description of formations encountered	from	to
<i>clay</i>	<i>0</i>	<i>20</i>
<i>clay</i>	<i>20</i>	<i>45</i>
<i>grd shell</i>	<i>45</i>	<i>75</i>
<i>clay</i>	<i>75</i>	<i>110</i>
<i>grd shell</i>	<i>110</i>	<i>120</i>
<i>grd</i>	<i>120</i>	<i>150</i>

WELL LOCATION:
sec *4* T *3* N R *8* E
6 miles *East* of *McComb*
(distance) (direction) (nearest town)

WELL PURPOSE:
(home, irrigation, municipal, industrial)

- WELL COMPLETION DATA:
- (1) diameter (inches) *4*
 - (2) total depth (feet) *150*
 - (3) static water level (feet) *85* below above top of ground.
 - (4) casing *PI* *144*
(material) (depth)
(size) if telescope see back.
 - (5) screen *6* *144*
(length) (depth to top)
4 *PI*
(size) (material)
 - (6) pump *1*
(HP) (yield gpm)
(type power)
 - (7) electric log (yes or no)
(organization running log)
 - (8) how well bottom plugged *Sealed*

CODED


MAY 6 1971

DRILLERS REMARKS:
AD pump installed

MISS. BD. OF
WATER COMMISSIONERS

If well telescopes please sketch and show depths.

GROUND LEVEL

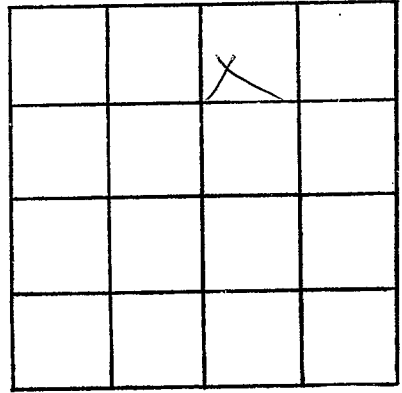

SECTION 14

Please indicate well location X.

ADDITIONAL INFORMATION

A series of horizontal lines for writing additional information.

If more than one screen, show locations of each on sketch.