

E 58 element

4-30-64

WATER WELL DRILLERS LOG

RIKE CODED

Date: 4-30, 1964, Driller: Chester Reeves County Pike  
(Name)

(1) Owner of Land: P. T. Hambrick  
(Name)  
RFD 1, McComb  
(Address)

(2) Location: 1/4, 1/4, Sec. 9, T. 8, R. 8  
2 miles East of McComb  
(distance) (direction) (Nearest Town)

(3) Topography: Hilly  
(Hilly) (Flat) (Level)

(4) Purpose of Well: Domestic  
(Domestic Irrigation, Municipal, Industrial, Other)

Description & Color of Materials Sand, Clay, Red Clay, Shell, etc.	Thick-ness Feet	Depth Feet
Severely Clay	20	00
Sandy clay	65	85
Small pebbles	20	105
Small gravel	60	165
Small gravel	10	175

Information upon completion of well:

(1) Diameter 4 inches.

(2) Total Depth 175 feet.

(3) Water Level 90 feet below top of ground.


(4) Cased to Bottom, Size 4

(5) Screen: Size 4", Length 7'

(6) Were any formations sealed against pollution?  
yes,  no.

If YES depth of formation \_\_\_\_\_  
Why \_\_\_\_\_

Drillers Remarks: Old well  
Bad -

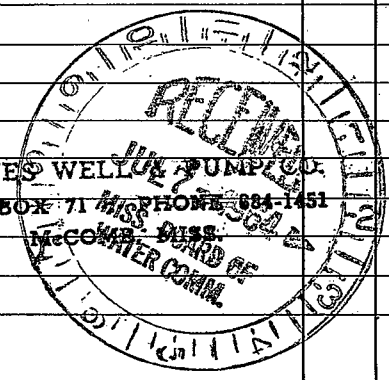

(Use Back Side)

Well No.

1948

1948

