

ESSEment

CODED

4-2-64

WATER WELL DRILLERS LOG

Date: 4-2, 1964, Driller: Chester Reeves County Pike (Name)


(1) Owner of Land: Mrs. Sophie Koach (Name)
 RFD 2, McComb, Miss (Address)
 Location: 1/4, 1/4, Sec. 5 3 8 T R
 2 miles EAST of McComb (distance) (direction) (Nearest Town)
 Topography: Hilly (Hilly) (Flat) (Level)
 Purpose of Well: Domestic (Domestic Irrigation, Municipal, Industrial, Other)

Description & Color of Materials (Sand, Clay, Red Clay, Shell, etc.)	Thickness Feet	Depth Feet
Red Clay	18	18
Sandy Yellow Sand	95	113
Blueshale	112	225
Clean coarse sand	20	251

Information upon completion of well:

(1) Diameter 4 inches.
 (2) Total Depth 251 feet.
 (3) Water Level 108 feet below top of ground.
 (4) Cased to Bottom, Size 4"
 (5) Screen: Size 4", Length 9ft.
 (6) Were any formations sealed against pollution?
 yes, no.

If YES depth of formation _____
 Why _____
 Drillers Remarks: old well
 Rusty - J

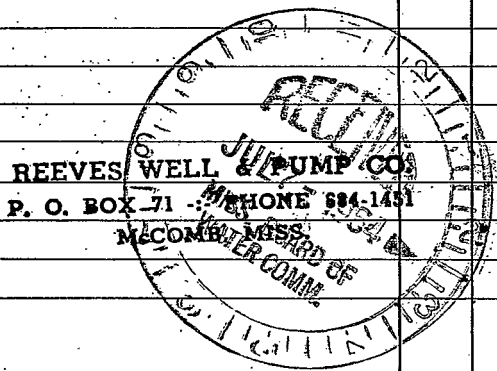

(Use Back Side)

Well No.

