

PIKE
E 57
2-10-64

MISSISSIPPI BOARD OF WATER COMMISSIONERS

CODED

WATER WELL DRILLERS LOG

Date: ~~2-CODED~~ 1964, Driller: Chester Reeves County PIKE
(Name)

(1) Owner of Land	Description & Color of Materials Sand, Clay, Red Clay, Shell, etc.	Thick- ness Feet	Dep- th Feet
<u>Mrs. Lela Muller</u> (Name) <u>RFD 2, M. Lamb</u> (Address)	<u>Red clay</u>	<u>25</u>	<u>25</u>
(2) Location: <u>1/4</u> , <u>1/4</u> , Sec. <u>21 3-8</u> T. <u>R</u>	<u>Sand & gravel</u>	<u>15</u>	<u>40</u>
<u>3</u> miles <u>EAST</u> of <u>M. Lamb</u> (distance) (direction) (Nearest Town)	<u>Red chert</u>	<u>10</u>	<u>50</u>
(3) Topography: <u>Hilly</u> (Hilly) <u>Flat</u> (Flat) <u>Level</u> (Level)	<u>Sand & gravel</u>	<u>48</u>	<u>98</u>
(4) Purpose of Well: <u>Domestic</u> (Domestic Irrigation Municipal, Industrial, Other)	<u>white chalk</u>	<u>17</u>	<u>115</u>
	<u>Sand & small gravel</u>	<u>8</u>	<u>123</u>

Information upon completion of well:


- (1) Diameter 4 inches.
- (2) Total Depth 123 feet.
- (3) Water Level 99 feet below top of ground.
- (4) Cased to Bottom Size 4
- (5) Screen: Size 4, Length 8 ft.
- (6) Were any formations sealed against pollution?
_____ yes, no.

If YES depth of formation _____

Why _____

Drillers Remarks: old well
with iron pipe
Rusty

REEVES WELL & PUMP CO.
P. O. BOX 71 - PHONE 684-1451
McCOMB, MISS.

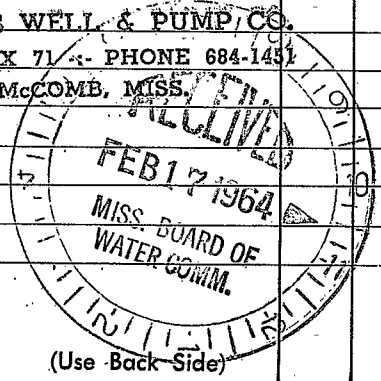

Well No.

1941
1942
1943
2025