

E 58
4-7-61 CODED

WATER WELL DRILLERS LOG

7 CODED

Date: 4-7, 1961, Driller: Master Reeves County: Pike
(Name)

(1) Owner of Land: W. W. Williams
(Name)
RFD Summit
(Address)

(2) Location: $\frac{1}{4}$, $\frac{1}{4}$, Sec. 21 3 8 T. R.
3 miles east of McComb
(distance) (direction) (Nearest Town)

(3) Topography: Hilly
(Hilly) (Flat) (Level)

(4) Purpose of Well: Domestic
(Domestic Irrigation
Municipal, Industrial, Other)

Description & Color of Materials Sand, Clay, Red Clay, Shell, etc.	Thick- ness Feet	Depth Feet
<u>Red Clay</u>	<u>20</u>	<u>20</u>
<u>Red Sandy Sand</u>	<u>115</u>	<u>135</u>
<u>white sand</u>	<u>54</u>	<u>179</u>
<u>orange white sand & gravel</u>	<u>12</u>	<u>191</u>

Information upon completion of well:

(1) Diameter: 2 inches.

(2) Total Depth: 191 feet.

(3) Water Level: 96 feet below top of ground.

(4) Cased to: 186, Size: 2'


(5) Screen: Size: 1 1/4, Length: 6'

(6) Were any formations sealed against pollution?
_____ yes, no.

If YES depth of formation _____

Why _____

Drillers Remarks: Had old tile well -

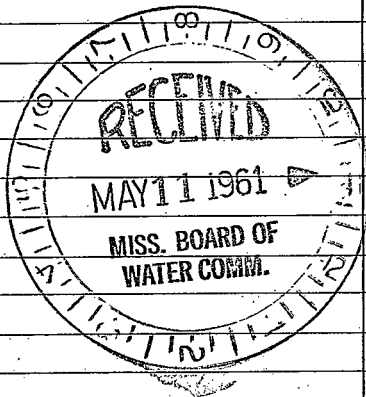

REEVES WELL AND PUMP CO
Phone 1250
McCOMB, MISSISSIPPI

(Use Back Side)

Well No.

