

PIKE
E EGO

MISSISSIPPI BOARD OF WATER COMMISSIONERS

CODED

WATER WELL DRILLERS LOG

2-4-63
CODE 63

Date: 2-4, 1963, Driller: Chester Reeves County, Pike
(Name)

(1) Owner of Land:	Description & Color of Materials Sand, Clay, Red Clay, Shell, etc.	Thick- ness Feet	Depth Feet
(Name) <u>E. J. Price</u> (Address) <u>Rt. 2, McComb.</u>	<u>red clay</u>	<u>20</u>	<u>20</u>
(2) Location: $\frac{1}{4}$, $\frac{1}{4}$, Sec. <u>5 3 8</u> T <u>3</u> R <u>8</u> <u>1 1/2</u> miles <u>EAST</u> of <u>McComb</u> (distance) (direction) (Nearest Town)	<u>clay</u> <u>gravel</u> <u>crack</u>	<u>60</u> <u>14</u> <u>6</u>	<u>80</u> <u>94</u> <u>100</u>
(3) Topography: <u>Hilly</u> (Hilly) (Flat) (Level)	<u>fine sand</u>	<u>21</u>	<u>121</u>
(4) Purpose of Well: <u>Domestic</u> (Domestic Irrigation Municipal, Industrial, Other)			


Information upon completion of well:

- (1) Diameter 2" inches.
- (2) Total Depth 121 feet.
- (3) Water Level 76 feet below top of ground.
- (4) Cased to bottom, size 2'
- (5) Screen: Size 1/4, Length 6'
- (6) Were any formations sealed against pollution?
yes, no.

If YES depth of formation _____

Why _____

Drillers, Remarks: old well
sanded -

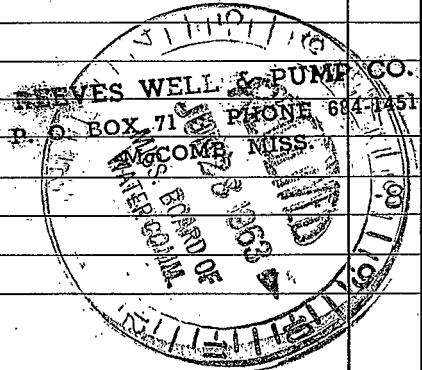

(Use Back Side)

Well No.

