

PIKE  
E 61

MISSISSIPPI BOARD OF WATER COMMISSIONERS

3-5-63

CODED <sup>F</sup>

WATER WELL DRILLERS LOG

CODED

Date: 3-5, 1963, Driller: Chester Reeves County: PIKE


(Name)

- (1) Owner of Land: Fred Jenkins (Name)  
RFD 1, McLamb. (Address)
- (2) Location: 1/4, 1/4, Sec. 8 T3 R 8  
1 1/2 miles East of McLamb. (distance) (direction) (Nearest Town)
- (3) Topography: Hilly (Hilly) (Flat) (Level)
- (4) Purpose of Well: Domestic (Domestic Irrigation Municipal, Industrial, Other)

Description & Color of Materials Sand, Clay, Red Clay, Shell, etc.	Thick- ness Feet	De Fe
Red clay	15	15
sand & red clay	90	95
sand & gravel	8	13

Information upon completion of well:

- (1) Diameter 4" inches.
- (2) Total Depth 113 feet.
- (3) Water Level 87 feet below top of ground.
- (4) Cased to Bottom Size 4"
- (5) Screen: Size 4", Length 4'
- (6) Were any formations sealed against pollution?  
yes,  no.

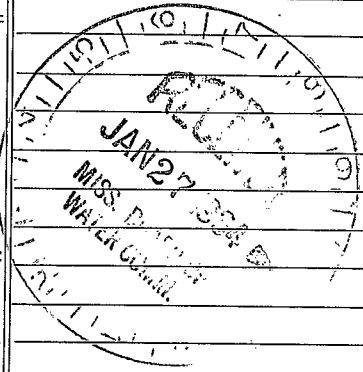

REEVES WELL & PUMP CO.  
P. O. BOX 71 PHONE 684-1451

If YES depth of formation \_\_\_\_\_  
Why \_\_\_\_\_

Drillers Remarks: Had no previous well.

(Use Back Side)

Well No.

*[The page contains extremely faint, illegible text, likely bleed-through from the reverse side of the document. The text is scattered across the page and cannot be transcribed.]*