

E *EA* CODED

CODED

11-27-65

WATER WELL DRILLERS LOG

Date: 11-27, 1965, Driller: Chester Reeves County Pike
 (Name)

(1) Owner of Land:	Description & Color of Materials Sand, Clay, Red Clay, Shell, etc.	Thick- ness Feet	Depth Feet
<u>Don L. A. Norman</u> (Name) <u>Rt 2, McComb</u> (Address)	<u>10' clay</u> <u>Small gravel</u>	<u>10</u>	<u>10</u>
(2) Location: $\frac{1}{4}$, $\frac{1}{4}$, Sec <u>15 38</u>	<u>Red sand</u>	<u>65</u>	<u>75</u>
(3) Topography: <u>5 miles East of McComb</u> (distance) (direction) (Nearest Town) <u>in Salmeron Wood</u>	<u>Red sand & clay</u> <u>sand</u>	<u>6</u>	<u>81</u>
(4) Purpose of Well: <u>Domestic</u> (Domestic Irrigation Municipal, Industrial, Other)			


Information upon completion of well:

- (1) Diameter 4 inches.
- (2) Total Depth 81 feet.
- (3) Water Level 38 feet below top of ground.
- (4) Cased to bottom, Size 4"
- (5) Screen: Size 4", Length 6'
- (6) Were any formations sealed against pollution?
 yes, no.

If YES depth of formation _____
 Why _____

Drillers Remarks: New location
no previous well.

Cannot locate

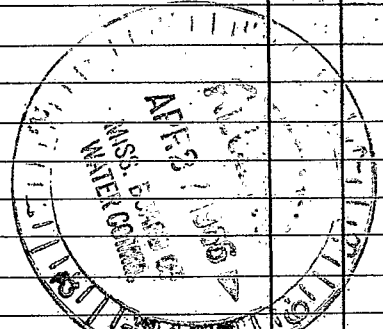

BEEVES WELL DRILLING CO.
 P. O. BOX 71 -- PHONE 584-1431
 McCOMB, MISS.

(Use Back Side)

Well No.

Faint, illegible text, possibly bleed-through from the reverse side of the page. The text is too light to transcribe accurately.