

PIKE
E 65
12-20-65

MISSISSIPPI BOARD OF WATER COMMISSIONERS

cannot O.K. QR

12/5/68

WATER WELL DRILLERS LOG

CODED

Date: 12-20, 1965, Driller: J. T. Wright For County Pike
(Name)

(1) Owner of Land: Mrs. John Shuburn
(Name)
McComb, Miss
(Address)

(2) Location: 20 $\frac{1}{4}$, $\frac{1}{4}$, Sec. 29 T. 38 R. 6
4 miles East of McComb
(distance) (direction) (Nearest Town)

(3) Topography: Hilly
(Hilly) (Flat) (Level)

(4) Purpose of Well: Domestic
(Domestic Irrigation
Municipal, Industrial, Other)

Description & Color of Materials Sand, Clay, Red Clay, Shell, etc.	Thick- ness Feet	Depth Feet
<u>Sandy Clay</u>	<u>30</u>	<u>30</u>
<u>Sand + Gravel</u>	<u>30</u>	<u>60</u>
<u>Sand</u>	<u>13</u>	<u>73</u>

Information upon completion of well:

(1) Diameter 4" inches.

(2) Total Depth 73' feet.


(3) Water Level 60' feet below top of ground.

(4) Cased to 73', Size 4"

(5) Screen: Size 4", Length 6'

(6) Were any formations sealed against pollution?
 yes, no.

Cannot locate.
RM

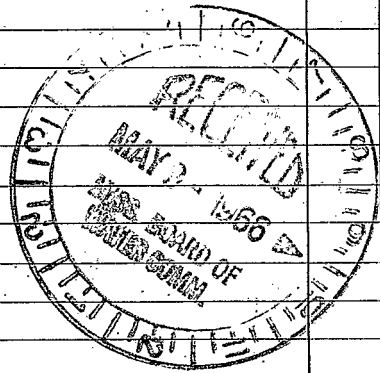

If YES depth of formation _____
Why _____
Drillers Remarks: _____

(Use Back Side)

Well No.

Lloyd young - Buller