

CODED

Below Red Line

MISSISSIPPI
BOARD OF WATER COMMISSIONERS
416 North State Street
Jackson, Mississippi 39201

Pike
E 67
11-13-68

WATER WELL DRILLERS LOG

Nov 13 1968 *Fitzgerald Water Well* firm name *Pike* county well located

LANDOWNER: *Lora Catt*
McComb Rt 1 Miss
(mailing address)

description of formations encountered	from	to
<i>top soil / clay</i>	<i>0</i>	<i>10</i>
<i>sand</i>	<i>10</i>	<i>28</i>
<i>gravel / sand</i>	<i>28</i>	<i>64</i>
<i>white chalk</i>	<i>64</i>	

WELL LOCATION:
sec *27* T *3* N R *8* E
5 miles *SE* of *McComb*
(distance) (direction) (nearest town)

WELL PURPOSE: *home*
(home, irrigation, municipal, industrial)

- WELL COMPLETION DATA:
- (1) diameter (inches) *4*
 - (2) total depth (feet) *64*
 - (3) static water level (feet) *50* below top of ground.
 - (4) casing *plastic 58'*
(material) (depth)
4 (size) if telescope see back.
 - (5) screen *6' 58'*
(length) (depth to top)
4 (size) *Sch 40* (material)
 - (6) pump *Jet 10g*
(HP) (yield gpm)
Elec (type power)
 - (7) electric log *no*
(yes or no)
(organization running log)
 - (8) how well bottom plugged *Wed peg*

DRILLERS REMARKS:


DEC - 9 1968

MISS. BD. OF WATER COMMISSIONERS

DEC - 2 1968
MISS. BD. OF WATER COMMISSIONERS

If well telescopes please sketch and show depths.

GROUND LEVEL

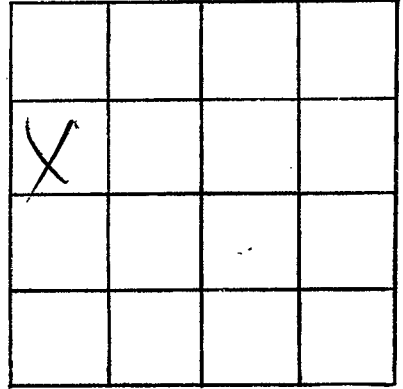

SECTION 27

Please indicate well location X.

ADDITIONAL INFORMATION

If more than one screen,
show locations of each on sketch.