

CODED

CODED

MISSISSIPPI
 BOARD OF WATER COMMISSIONERS
 416 North State Street
 Jackson, Mississippi 39201

WATER WELL DRILLERS LOG

Pike
ELB
9-23-68
9-23

9-23 1968 Fitzgerald well log Pike
 date well completed firm name county well located

LANDOWNER:

Al Fitzgerald

description of formations encountered

from to

RR. McComb, Miss.
(mailing address)

<u>Red clay</u>	<u>0</u>	<u>20</u>
<u>Red sand</u>	<u>20</u>	<u>60</u>
<u>Fine sand</u>	<u>60</u>	<u>80</u>
<u>Coarse sand</u>	<u>80</u>	<u>90</u>
<u>Coarse sand & gravel</u>	<u>90</u>	<u>96</u>

WELL LOCATION:


sec. 2 T. 3 N R. 8 E
 S W
5 miles E of McComb
 (distance) (direction) (nearest town)

WELL PURPOSE:

Home
(home, irrigation, municipal, industrial)

WELL COMPLETION DATA:


- (1) diameter (inches) 4
- (2) total depth (feet) 96
- (3) static water level (feet) 70 below above top of ground.
- (4) casing Plastic 90,
(material) (depth)
4 if telescope see back.
(size)
- (5) screen 6', 90
(length) (depth to top)
4, Plastic
(size) (material)
- (6) pump 1/2, 12
(HP) (yield gpm)
Electric
(type power)
- (7) electric log no
(yes or no)
(organization running log)
- (8) how well bottom plugged Wood peg

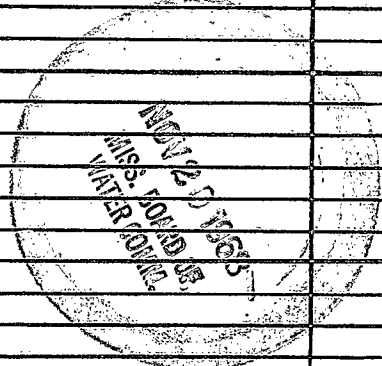

DRILLERS REMARKS:

If well telescopes please sketch and show depths.

GROUND LEVEL

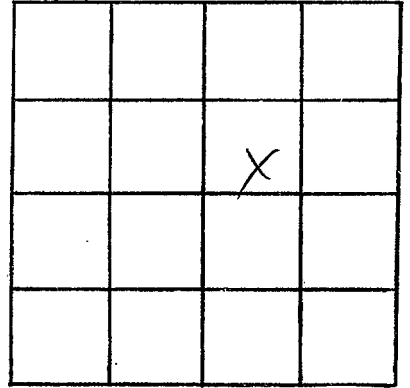

SECTION 5

Please indicate well location X.

ADDITIONAL INFORMATION

If more than one screen, show locations of each on sketch.