

**COILED**  
Pike  
E 70  
12-23-68

MISSISSIPPI  
 BOARD OF WATER COMMISSIONERS  
 416 North State Street  
 Jackson, Mississippi 39201

**CODED**

**WATER WELL DRILLERS LOG**

12-23 1968 Fitzgerald W/W Service Pike  
 date well completed firm name county well located

LANDOWNER: JF Davis  
McComb RH MISS

description of formations encountered	from	to
	<u>top soil &amp; clay</u>	<u>0</u>

(mailing address)

<u>Red sand</u>	<u>20</u>	<u>85</u>
<u>sand + gravel</u>	<u>85</u>	<u>120</u>

WELL LOCATION:  
 sec 21 T 3 N R 8 E  
1 miles SE of McComb  
 (distance) (direction) (nearest town)

<u>Chalky</u>	<u>120</u>	<u>150</u>
<u>white sand + gravel</u>	<u>150</u>	<u>190</u>

WELL PURPOSE: home  
 (home, irrigation, municipal, industrial)

**WELL COMPLETION DATA:**

- (1) diameter (inches) 4
- (2) total depth (feet) 138
- (3) static water level (feet) 115 below top of ground.
- (4) casing plastic 132  
 (material) (depth)
- 4 if telescope see back.  
 (size)
- (5) screen 6' 132  
 (length) (depth to top)
- 4 Sch 40  
 (size) (material)
- (6) pump 1 Set 6  
 (HP) (yield gpm)
- Elec  
 (type power)
- (7) electric log NO  
 (yes or no)

**CODED**

(organization running log)


- (8) how well bottom plugged W/rod plug

DRILLERS REMARKS:

JAN 2 1969  
 MISS. Bd. of  
 WATER COMMISSIONERS

If well telescopes please sketch and show depths.

GROUND LEVEL

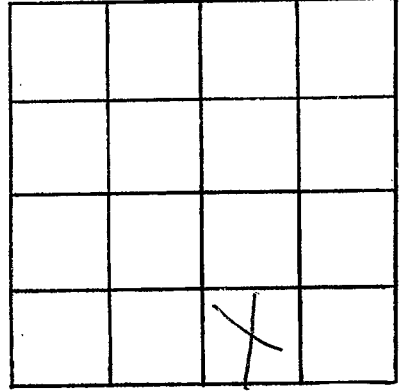

SECTION 21

Please indicate well location X.

ADDITIONAL INFORMATION

If more than one screen, show locations of each on sketch.