

PIKE coded

Pike
F72 COD
7-68

MISSISSIPPI
 BOARD OF WATER COMMISSIONERS
 416 North State Street
 Jackson, Mississippi 39201

WATER WELL DRILLERS LOG

July 30 1968 Reeves well Pump Co Pike
 date well completed firm name county well located

LANDOWNER: Mrs. L.S. Baker
 Mableton, Miss.
 (mailing address)

description of formations encountered	from	to
Red clay	0	8
Red sand	8	20
Sand & gravel	20	58

WELL LOCATION:
 sec 3 T 3 N R 8 E
 12 miles S of Farmwood
 (distance) (direction) (nearest town)

WELL PURPOSE: Home
 (home, irrigation, municipal, industrial)


WELL COMPLETION DATA:

- (1) diameter (inches) 4 1/2
- (2) total depth (feet) 58
- (3) static water level (feet) 19 below top of ground.
- (4) casing Plastic bottom (material) (depth)
- (size) if telescope see back.
- (5) screen 6' 52' (length) (depth to top)
- 4" Plastic (size) (material)
- (6) pump Self lift pump (HP) (yield gpm)
- electric (type power)
- (7) electric log 10' (yes or no)

(organization running log)


(8) how well bottom plugged wooden plug

DRILLERS REMARKS:
 self well
 Dry.

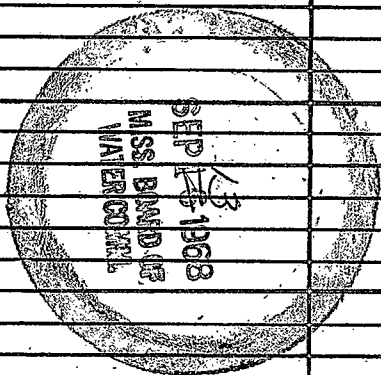

If well telescopes please sketch and show depths.

GROUND LEVEL

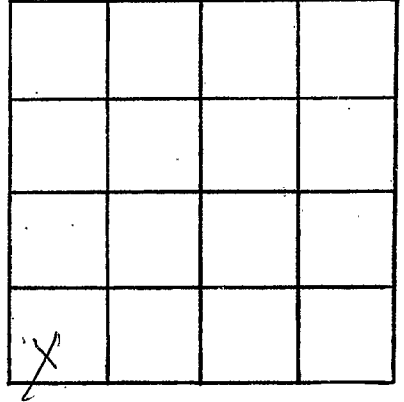

SECTION 31

Please indicate well location X.

ADDITIONAL INFORMATION

If more than one screen, show locations of each on sketch.