

Pike  
E74  
5-1-69

MISSISSIPPI  
 BOARD OF WATER COMMISSIONERS  
 416 North State Street  
 Jackson, Mississippi 39201

CODED

WATER WELL DRILLERS LOG

5-1 19 69 Fitzgerald Well Serv. Pike  
 date well completed firm name county well located

LANDOWNER:

Elijah Patterson

Rt 2 - McComb, Miss.  
 (mailing address)

description of formations encountered

from to

<u>Red Clay</u>	<u>0</u>	<u>20</u>
<u>Red sand &amp; gravel</u>	<u>20</u>	<u>80</u>
<u>Red gravel</u>	<u>80</u>	<u>100</u>
<u>Coarse sand gravel</u>	<u>100</u>	<u>122</u>

WELL LOCATION:

sec. 35 T. 3 N R. 8 E  
 S W  
6 miles SE of McComb  
 (distance) (direction) (nearest town)

WELL PURPOSE: Home  
 (home, irrigation, municipal, industrial)

WELL COMPLETION DATA:

- (1) diameter (inches) 4
- (2) total depth (feet) 122
- (3) static water level (feet) 100 below top of ground.
- (4) casing Plastic, 116,  
 (material) (depth)  
4 if telescope see back.  
 (size)
- (5) screen 6, 116  
 (length) (depth to top)  
4, Plastic  
 (size) (material)
- (6) pump 1, 8  
 (HP) (yield gpm)  
elec  
 (type power)
- (7) electric log No  
 (yes or no)  
 (organization running log)
- (8) how well bottom plugged wood plug

CODED


JUN 2 - 1969

DRILLERS REMARKS:

MISS. DEPT. OF  
 WATER CONTROL

If well telescopes please sketch and show depths.

GROUND LEVEL

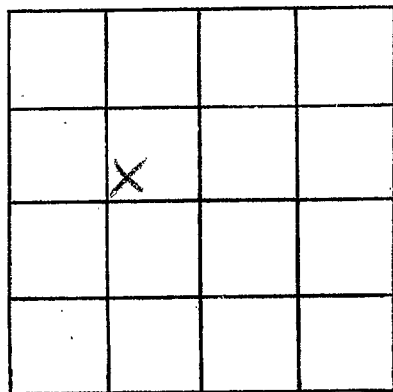

SECTION 35

Please indicate well location X.

ADDITIONAL INFORMATION

If more than one screen, show locations of each on sketch.