

Pike **CODED**
E 75
 1-29-69

MISSISSIPPI
 BOARD OF WATER COMMISSIONERS **CODED**
 416 North State Street
 Jackson, Mississippi 39201

WATER WELL DRILLERS LOG

1-29-1969 *Fitzgerald Water Well* *Pike*
 date well completed firm name county well located

LANDOWNER: *Barnett Ogwin*
McComb MS

description of formations encountered	from	to
<i>Red clay</i>	<i>0</i>	<i>15</i>
<i>Red sand</i>	<i>15</i>	<i>40</i>
<i>Coarse gravel</i>	<i>40</i>	<i>96</i>
<i>White chalk</i>	<i>96</i>	<i>160</i>
<i>Fine sand</i>	<i>160</i>	<i>200</i>
<i>Coarse sand & gravel</i>	<i>200</i>	<i>226</i>

(mailing address)

WELL LOCATION:
 sec. *3* T. *2* N. R. *2* E
1/4 miles *E* of *McComb*
 (distance) (direction) (nearest town)

WELL PURPOSE: *Fish pond*
 (home, irrigation, municipal, industrial)

WELL COMPLETION DATA:

- (1) diameter (inches) 4
- (2) total depth (feet) 226
- (3) static water level (feet) 85 below above top of ground.
- (4) casing 4" 206
 (material) (depth)
4 if telescope see back.
 (size)
- (5) screen 20' 206
 (length) (depth to top)
4" plastic
 (size) (material)
- (6) pump 5 85
 (HP) (yield gpm)
Elco
 (type power)
- (7) electric log No
 (yes or no)
- (organization running log)
- (8) how well bottom plugged wood plug


CODED

DRILLERS REMARKS:

MISS. Bd. of WATER COM. STAMP

If well telescopes please sketch and show depths.

GROUND LEVEL

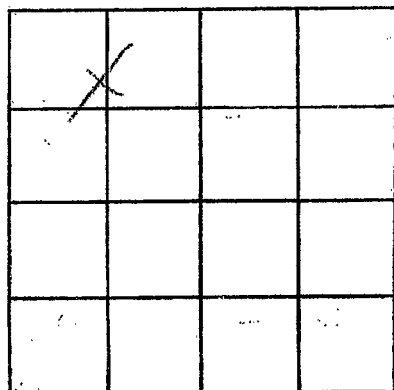

SECTION 4

Please indicate well location X.

ADDITIONAL INFORMATION

If more than one screen, show locations of each on sketch.