

PIKE
E 76
3-1-69

MISSISSIPPI
BOARD OF WATER COMMISSIONERS
416 North State Street
Jackson, Mississippi 39201

WATER WELL DRILLERS LOG

Mar. 1 1969 J.T. Compton & Son P. 15 CODED
date well completed firm name county well located

LANDOWNER: Jeriah Pitman

description of formations encountered	from to	
	ft	ft

McComb Miss.
(mailing address)

<u>1/104</u> <u>sands & rocks</u>	<u>0</u>	<u>30</u>
	<u>30</u>	<u>104</u>

WELL LOCATION:
sec 19 T 3 N R 8 E
S W
3 miles South of McComb
(distance) (direction) (nearest town)

WELL PURPOSE: Home
(home, irrigation, municipal, industrial)

WELL COMPLETION DATA:


- (1) diameter (inches) 4"
- (2) total depth (feet) 104'
- (3) static water level (feet) 70' below above top of ground.
- (4) casing Plastic 98'
(material) (depth)
(size) If telescope see back.
- (5) screen 6' 104'
(length) (depth to top)
4" Plastic
(size) (material)
- (6) pump 1/8 8
(HP) (yield gpm)
A.C.
(type power)
- (7) electric log _____
(yes or no)
(organization running log)
- (8) how well bottom plugged wood

DRILLERS REMARKS:

MAR 20 1969
MISS. Bd. of
WATER COMMISSIONERS

If well telescopes please sketch and show depths.

GROUND LEVEL

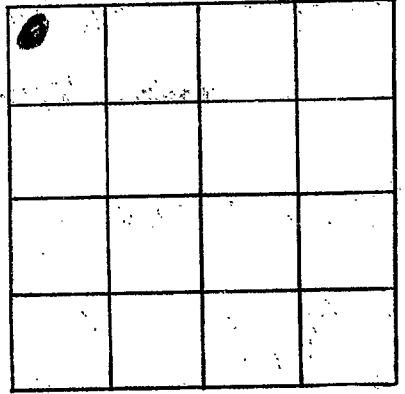

SECTION 19

Please indicate well location X.

ADDITIONAL INFORMATION

If more than one screen, show locations of each on sketch.