

CODED

CODED

MISSISSIPPI
BOARD OF WATER COMMISSIONERS
416 North State Street
Jackson, Mississippi 39201

WATER WELL DRILLERS LOG

Pike
E 79
4-14-69

4-14 date well completed
1969 Fitzgerald well log firm name
Pike county well located

LANDOWNER:
Leroy Jacques
RR. 21 Comb Miss.
(mailing address)

description of formations encountered	from	to
Red clay	0	20
Red sand	20	60
Red gravel	60	90
Red sand & gravel	90	120
Coarse sand & gravel	120	130

WELL LOCATION:
sec. 26 T. 3 N. R. 18 E.
S W
5 miles E of Comb
(distance) (direction) (nearest town)

WELL PURPOSE: Home
(home, irrigation, municipal, industrial)

- WELL COMPLETION DATA:
- (1) diameter (inches) 4
 - (2) total depth (feet) 130
 - (3) static water level (feet) 110 below top of ground.
 - (4) casing Plastic, 124 (material) (depth)
4 (size) If telescope see back.
 - (5) screen 6, 124 (length) (depth to top)
4 (size) Plastic (material)
 - (6) pump 1/2, 10 (HP) (yield gpm)
Cbe (type power)
 - (7) electric log ~~no~~ (yes or no)
(organization running log)
 - (8) how well bottom plugged ~~badly~~

DRILLERS REMARKS:


EXHIBIT

APR 28 1969

MADE BY THE WATER BOARD

If well telescopes please sketch and show depths.

GROUND LEVEL

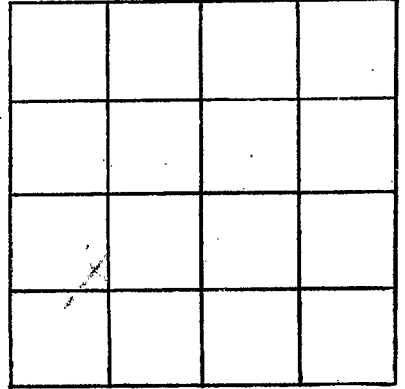

SECTION 26

Please indicate well location X.

ADDITIONAL INFORMATION

If more than one screen, show locations of each on sketch.