

Pike
E 80
7-69

MISSISSIPPI
BOARD OF WATER COMMISSIONERS
416 North State Street
Jackson, Mississippi 39201

CODED

WATER WELL DRILLERS LOG

7-7
date well completed

1969
Fitzgerald Well Drilling Co.
firm name

Pike
county well located

LANDOWNER:
Dore Edder
RR. McComb, Miss.
(mailing address)

description of formations encountered	from	to
Red clay	0	10
Red gravel	10	25
fine sand	25	65
Coarse sand & gravel	65	85

WELL LOCATION:
sec. 21 T. 3 N R. 9 E
8 miles E of McComb
(distance) (direction) (nearest town)

WELL PURPOSE: Home
(home, irrigation, municipal, industrial)

- WELL COMPLETION DATA:
- (1) diameter (inches) 4
 - (2) total depth (feet) 85
 - (3) static water level (feet) 30 below top of ground.
 - (4) casing Plastic 79 (material) (depth)
4 (size) if telescope see back.
 - (5) screen 6 79 (length) (depth to top)
4 (size) Plastic (material)
 - (6) pump 1/2 8 (HP) (yield gpm)
Electric (type power)
 - (7) electric log No (yes or no)
(organization running log)
 - (8) how well bottom plugged wool plug

CODED


AUG 4 1969

MISS. BD. OF WATER COMMISSIONERS

DRILLERS REMARKS:

If well telescopes please sketch and show depths.

GROUND LEVEL

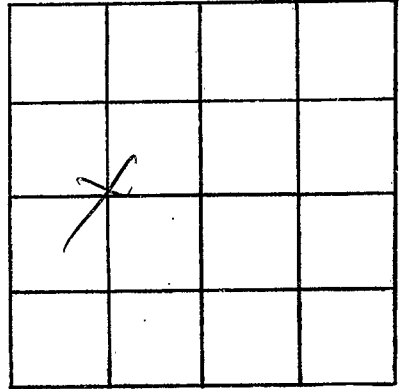

SECTION 21

Please indicate well location X.

ADDITIONAL INFORMATION

If more than one screen, show locations of each on sketch.