

Pike
E 81
8-69

MISSISSIPPI
BOARD OF WATER COMMISSIONERS
416 North State Street
Jackson, Mississippi 39201 **CODED**

WATER WELL DRILLERS LOG

8-1 19 69 *Fitzgerald Well Drilling* *Pike*
date well completed firm name county well located

LANDOWNER:
Julia Le Boeuf
Rt. 1, McComb Miss.
(mailing address)

description of formations encountered	from	to
<i>Red Clay</i>	<i>0</i>	<i>20</i>
<i>Red Sand</i>	<i>20</i>	<i>60</i>
<i>Red Gravel</i>	<i>60</i>	<i>90</i>
<i>Red Sand</i>	<i>90</i>	<i>110</i>
<i>Coarse Sand & gravel</i>	<i>110</i>	<i>159</i>

WELL LOCATION:
sec. *12* T. *3* N. R. *8* E
S W
6 miles *E* of *McComb*
(distance) (direction) (nearest town)

WELL PURPOSE: *Flow*
(home, irrigation, municipal, industrial)

- WELL COMPLETION DATA:
- (1) diameter (inches) *4*
 - (2) total depth (feet) *159*
 - (3) static water level (feet) *110* below above top of ground.
 - (4) casing *plastic*, *153*,
(material) (depth)
4 if telescope see back.
(size)
 - (5) screen *6*, *153*
(length) (depth to top)
4, *plastic*
(size) (material)
 - (6) pump *1/2*, *70*
(HP) (yield gpm)
el
(type power)
 - (7) electric log *no*
(yes or no)
(organization running log)
 - (8) how well bottom plugged *leaky*


CODED

AUG 4 1969
MISS. BD. OF WATER COMMISSIONERS

DRILLERS REMARKS:

If well telescopes please sketch and show depths.

GROUND LEVEL

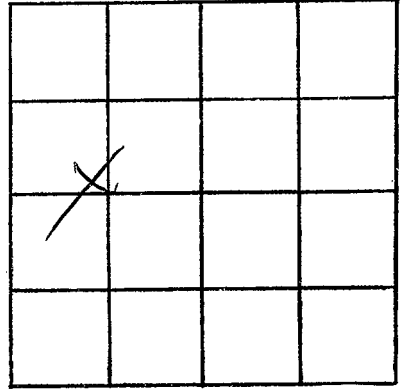

SECTION 13

Please indicate well location X.

ADDITIONAL INFORMATION

If more than one screen,
show locations of each on sketch.