

**CODED**

MISSISSIPPI  
BOARD OF WATER COMMISSIONERS  
416 North State Street  
Jackson, Mississippi 39201

WATER WELL DRILLERS LOG

Pike Co  
E 83  
3-7-70

March 7 1970 Reeves and Humphreys Pike Co  
date well completed firm name county well located

LANDOWNER Robert Reeves  
RT-1, McComb

description of formations encountered

from to

Red Clay 0 14  
Red Sand Gravel 14 45  
Red Chalk 45 66  
Red Gravel Sand 66 75

(mailing address)

WELL LOCATION:

sec. 28 T. 3 N. R. 9 E  
2 miles ENE of Fenwick  
(distance) (direction) (nearest town)

WELL PURPOSE: drinking  
(home, irrigation, municipal, industrial)

WELL COMPLETION DATA:

- (1) diameter (inches) 4"
- (2) total depth (feet) 75
- (3) static water level (feet) 45 below top of ground.
- (4) casing Plastic Bottom  
(material) (depth)

- (5) screen 6' 69'  
(length) (depth to top)  
4" Plastic  
(size) (material)

- (6) pump 1/2 Sub-10  
(HP) (yield gpm)  
elect.  
(type power)

- (7) electric log NO  
(yes or no)

(organization running log)

- (8) how well bottom plugged wooden plug

DRILLERS REMARKS:

New location


**CODED**

MAR 23 1970

MISS. BD. OF WATER COMMISSIONERS

If well telescopes please sketch and show depths.

GROUND LEVEL

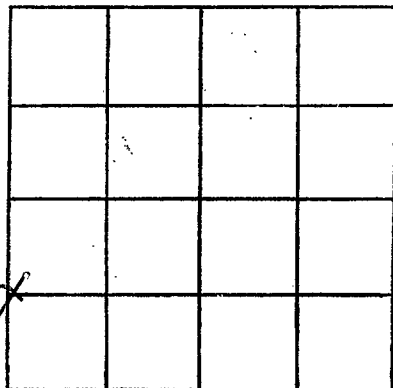

SECTION 28

Please indicate well location X.

ADDITIONAL INFORMATION

If more than one screen,  
show locations of each on sketch.