

Pike Co  
E 85  
3-24-70

MISSISSIPPI  
BOARD OF WATER COMMISSIONERS  
416 North State Street  
Jackson, Mississippi 39201

WATER WELL DRILLERS LOG

March 20, 1970 Reeves Well & Pump Co. Pike  
date well completed firm name county well located

LANDOWNER: Reeves Well & Pump Co.  
Fremont  
(mailing address)  
WELL LOCATION:  
sec 31 T 3 (N) R 4 (E) 065  
3/4 miles SE of Fremont  
(distance) (direction) (nearest town)

description of formations encountered	from	to
<u>Red Sandy clay</u>	<u>0</u>	<u>12</u>
<u>mixed sand gravel</u>	<u>12</u>	<u>62</u>
<u>gravel &amp; sand</u>	<u>62</u>	<u>71</u>

WELL PURPOSE: Home  
(home, irrigation, municipal, industrial)

WELL COMPLETION DATA:  
(1) diameter (inches) 4"  
(2) total depth (feet) 71  
(3) static water level (feet) 20 below top of ground.  
(4) casing plastic Bottom  
(material) (depth)  
If telescope see back.  
(size)  
(5) screen 6' 65'  
(length) (depth to top)  
4" Plastic  
(size) (material)  
(6) pump 1/2 hp - 12  
(HP) (yield gpm)  
split  
(type power)  
(7) electric log no  
(yes or no)  
(organization running log)

MAY 14 1970


MISS. BD. OF  
WATER COMM.

(8) how well bottom plugged wooden plug  
DRILLERS REMARKS:  
New home

REEVES WELL & PUMP CO.  
P. O. BOX 71 - PHONE 684-1444  
MCCOMB, MISS.

If well telescopes please sketch and show depths.

GROUND LEVEL

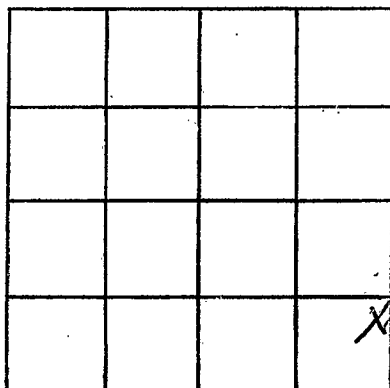

SECTION 31

Please indicate well location X.

ADDITIONAL INFORMATION

If more than one screen,  
show locations of each on sketch.