

Pike Co
 E 86
 4-2-70

MISSISSIPPI
 BOARD OF WATER COMMISSIONERS
 416 North State Street
 Jackson, Mississippi 39201

WATER WELL DRILLERS LOG

April 2, 1970 Chester Reeves Pike
 date well completed firm name county well located

LANDOWNER: Craft
 Alumina Co
 McComb
 (mailing address)

WELL LOCATION:
 sec 7 T 30 N R 8 E 065
 south of St. McComb
 miles (distance) of (direction) (nearest town)

WELL PURPOSE: Industrial
 (home, irrigation, municipal, industrial)

WELL COMPLETION DATA:

- (1) diameter (inches) 4"
- (2) total depth (feet) 75
- (3) static water level (feet) 33 below top of ground
- (4) casing Plastic bottom (material) (depth)
- (5) screen 10' length, 65' depth to top, 4" size, Plastic material
- (6) pump 1/2 HP, 30 yield gpm, Jet type power
- (7) electric log no (yes or no)
- (8) how well bottom plugged work by plug

description of formations encountered	depth	
	from	to
Red chalky clay	0	27
Red sandy	27	48
Gravel & sand	48	75


MAY 14 1970

DRILLERS REMARKS:
 for cooling water in plant

MISS. BD. OF
 WATER COMMISSIONERS

If well telescopes please sketch and show depths.

GROUND LEVEL

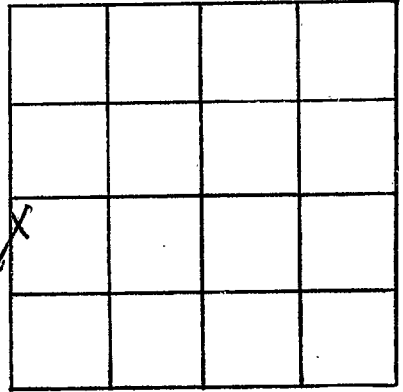

SECTION 7

Please indicate well location X.

ADDITIONAL INFORMATION

If more than one screen,
show locations of each on sketch.