

Pike Co
E 87
3-14-70

MISSISSIPPI
 BOARD OF WATER COMMISSIONERS
 416 North State Street
 Jackson, Mississippi 39201

WATER WELL DRILLERS LOG

14 March 19 70 J. T. Compton, Inc. Pike
 date well completed firm name county well located

LANDOWNER:
Conal Hines
M. Cook
 (mailing address)

description of formations encountered	from	to
<u>Clay Shells</u>	<u>0</u>	<u>30</u>
<u>Chalk</u>	<u>30</u>	<u>55</u>
<u>Sand</u>	<u>55</u>	<u>85</u>
<u>Chalk</u>	<u>85</u>	<u>120</u>
<u>Sand</u>	<u>120</u>	<u>144</u>

WELL LOCATION:
 sec. 4 T. 3 R. 8
6 miles East of Summit
 (distance) (direction) (nearest town)

WELL PURPOSE:
 (home, irrigation, municipal, industrial)

- WELL COMPLETION DATA:
- (1) diameter (inches) 4
 - (2) total depth (feet) 144
 - (3) static water level (feet) 70 below above top of ground
 - (4) casing pl. 138
 (material) (depth)
 - 4 if telescope see back.
 (size)
 - (5) screen 6 138
 (length) (depth to top)
 - 4 pl.
 (size) (material)
 - (6) pump 1/2 10
 (HP) (yield gpm)
 - Elect.
 (type power)
 - (7) electric log _____
 (yes or no)

(organization running log)

(8) how well bottom plugged wood


DRILLERS REMARKS:

MAY 18 1970

MISS. BD. OF
 WATER COMM.

If well telescopes please sketch and show depths.

GROUND LEVEL

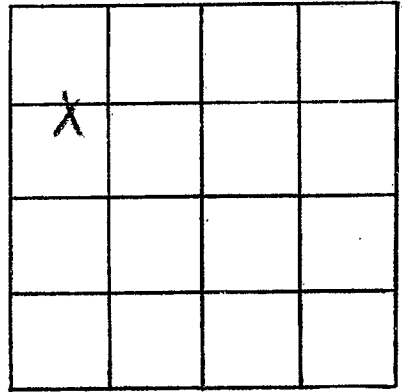

SECTION 44

Please indicate well location X.

ADDITIONAL INFORMATION

If more than one screen, show locations of each on sketch.