

MISSISSIPPI
 BOARD OF WATER COMMISSIONERS
 416 North State Street
 Jackson, Mississippi 39201

CODED

WATER WELL DRILLERS LOG

PIKE
E 88
8-17-70

Aug. 17 1970 Gronn Water Well Contr. Pike
 date well completed firm name county well located

LANDOWNER:	description of formations encountered	from	to
Jimmy Anderson McComb, Miss. (mailing address)	Citronelle	0	134
WELL LOCATION:			
sec. <u>17</u> T <u>30</u> N R <u>8</u> E <u>1</u> miles of <u>McComb</u> (distance) (direction) (nearest town)			
WELL PURPOSE: <u>home</u> (home, irrigation, municipal, industrial)			
WELL COMPLETION DATA:			
(1) diameter (inches) <u>6"</u>			
(2) total depth (feet) <u>134</u>			
(3) static water level (feet) <u>90</u> below top of ground. above			
(4) casing <u>PVC</u> <u>130</u> (material) (depth) <u>4"</u> (size) if telescope see back.			
(5) screen <u>4'</u> <u>130</u> (length) (depth to top) <u>.010</u> <u>PVC</u> (size) (material) <u>no</u>			
(6) pump _____ (HP) (yield gpm) (type power)			
(7) electric log <u>no</u> (yes or no) (organization running log)			
(8) how well bottom plugged <u>wood</u>			
DRILLERS REMARKS:			


CODED

SEP 17 1970

MISS. BD. OF
 WATER COMM.

If well telescopes please sketch and show depths.

GROUND LEVEL *

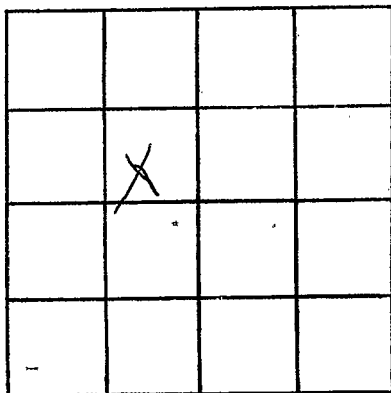

SECTION 17

Please indicate well location X.

ADDITIONAL INFORMATION

If more than one screen,
show locations of each on sketch.