

PIKE
E 89
8-28-70

MISSISSIPPI
BOARD OF WATER COMMISSIONERS
416 North State Street
Jackson, Mississippi 39201

CODED

WATER WELL DRILLERS LOG

8-28 1970 *Fitzgerald* *Pike*
date well completed firm name county well located

LANDOWNER:
John Paul Wilkins
R.R. 2, M. Comb, Miss
(mailing address)

description of formations encountered	from	to
<i>Red clay</i>	<i>0</i>	<i>20</i>
<i>Red sand</i>	<i>20</i>	<i>60</i>
<i>Red gravel</i>	<i>60</i>	<i>105</i>
<i>Coarse sand & gravel</i>	<i>105</i>	<i>139</i>

WELL LOCATION:
sec. *35* T. *3* N. R. *8* E
7 miles *E* of *M. Comb*
(distance) (direction) (nearest town)

WELL PURPOSE: *Home*
(home, irrigation, municipal, industrial)

- WELL COMPLETION DATA:
- (1) diameter (inches) *4*
 - (2) total depth (feet) *139*
 - (3) static water level (feet) *105* below top of ground.
 - (4) casing *flexible* *131*
(material) (depth)
4 If telescope see back.
(size)
 - (5) screen *8* *131*
(length) (depth to top)
4 *flexible*
(size) (material)
 - (6) pump *1* *6*
(HP) (yield gpm)
el
(type power)
 - (7) electric log *no*
(yes or no)
(organization running log)
 - (8) how well bottom plugged *good by*

CODED


SEP 14 1970

DRILLERS REMARKS:

MISS. BD. OF
WATER COMM.

If well telescopes please sketch and show depths.

GROUND LEVEL

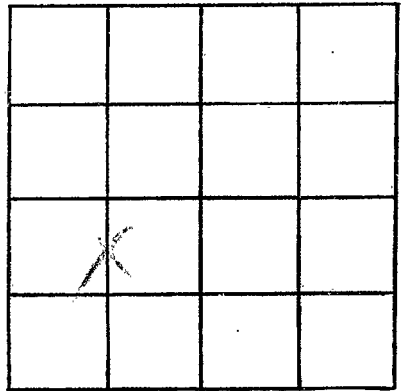

SECTION 55

Please indicate well location X.

ADDITIONAL INFORMATION

If more than one screen, show locations of each on sketch.