

Pike
E 90
5-20-70

MISSISSIPPI
BOARD OF WATER COMMISSIONERS
416 North State Street
Jackson, Mississippi 39201

CODED

WATER WELL DRILLERS LOG

May 20 1970 Chester Keene Pike
date well completed firm name county well located

LANDOWNER Paul
9th ridge
Rt. 1, McComb
(mailing address)

description of formations encountered	from	to
Red clay	0	22
Red sand	22	85
sand & gravel	85	95
white chalk	95	117
small gravel sand	117	130

WELL LOCATION:
sec. 14 T. 3 N. R. 9 E
4 miles ESE of McComb
(distance) (direction) (nearest town)

WELL PURPOSE: Home
(home, irrigation, municipal, industrial)

WELL COMPLETION DATA:

(1) diameter (inches) 4'

(2) total depth (feet) 130

(3) static water level (feet) 97 below above top of ground.

(4) casing Plastic Buttons
(material) (depth)

_____ if telescope see back.
(size)

(5) screen 6' 124'
(length) (depth to top)

4" Plastic
(size) (material)

(6) pump 3/4 Sub 10
(HP) (yield gpm)

Elect
(type power)

(7) electric log no
(yes or no)

_____ (organization running log)

CODED

(8) how well bottom plugged wooden plug


DRILLERS REMARKS:
New location -

JUL 21 1970

MISS. Bd. of
WATER COMMISSIONERS

If well telescopes please sketch and show depths.

GROUND LEVEL

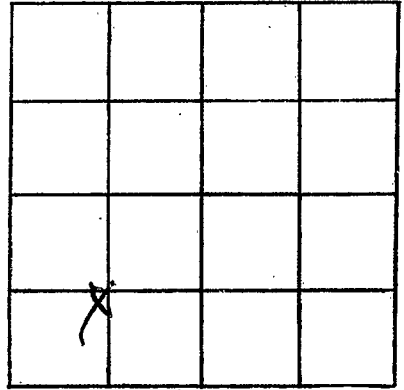

SECTION 14

Please indicate well location X.

ADDITIONAL INFORMATION

If more than one screen,
show locations of each on sketch.