

Pike  
E 91  
5-22-70

MISSISSIPPI  
BOARD OF WATER COMMISSIONERS  
416 North State Street  
Jackson, Mississippi 39201

**CODED**

WATER WELL DRILLERS LOG

May 22 1970 Chester Kernes Pike  
date well completed firm name county well located

LANDOWNER: Mark Roberts  
4-1, N. Camb

description of formations encountered

from to

red clay	0	22
red sand	22	35
sand & gravel	35	43
white chalk	43	115
sand & gravel	115	127

(mailing address)

WELL LOCATION:

sec. 14 T. 3 N. R. 5 E  
4 miles ESE of N. Camb  
(distance) (direction) (nearest town)

WELL PURPOSE: Home  
(home, irrigation, municipal, industrial)

WELL COMPLETION DATA:

- (1) diameter (inches) 4"
- (2) total depth (feet) 127
- (3) static water level (feet) 9.5 below above top of ground.
- (4) casing Plastic bottom  
(material) (depth)

(size) if telescope see back.

- (5) screen 6' 127'  
(length) (depth to top)  
4" Plastic  
(size) (material)

- (6) pump 3 sub 10  
(HP) (yield gpm)  
Electric  
(type power)

- (7) electric log No  
(yes or no)

(organization running log)

- (8) how well bottom plugged completely

DRILLERS REMARKS: New location


**CODED**

JUL 24 1970

MISS. BD. OF  
WATER COMMISSIONERS

If well telescopes please sketch and show depths.

GROUND LEVEL

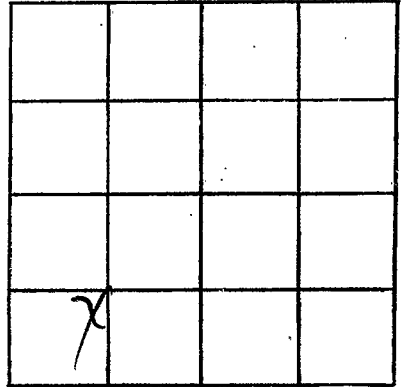

SECTION 14

Please indicate well location X.

ADDITIONAL INFORMATION

If more than one screen,  
show locations of each on sketch.