

Pike No  
E 92  
7-14-70

MISSISSIPPI  
BOARD OF WATER COMMISSIONERS  
416 North State Street  
Jackson, Mississippi 39201

**CODED**

WATER WELL DRILLERS LOG

7-14 1970 Fuller & Sons Pike  
date well completed firm name county well located

LANDOWNER:  
Russell Temple  
R.R. McComb, Miss.  
(mailing address)

description of formations encountered	from	to
<u>Red clay</u>	<u>0</u>	<u>20</u>
<u>Red sand &amp; silt</u>	<u>20</u>	<u>130</u>
<u>Coarse sand &amp; gravel</u>	<u>130</u>	<u>140</u>

WELL LOCATION:  
sec. 22 T. 3 N. R. 8 E  
5 miles E of McComb  
(distance) (direction) (nearest town)

WELL PURPOSE:  
(home, irrigation, municipal, industrial)

- WELL COMPLETION DATA:
- (1) diameter (inches) 4
  - (2) total depth (feet) 140
  - (3) static water level (feet) 110 below above top of ground.
  - (4) casing plastic, 132,  
(material) (depth)  
4 if telescope see back.  
(size)
  - (5) screen 8, 132  
(length) (depth to top)  
4, plastic  
(size) (material)
  - (6) pump 3/4, 6  
(HP) (yield gpm)  
Electric  
(type power)
  - (7) electric log no  
(yes or no)
  - (8) how well bottom plugged well

**CODED**


DRILLERS REMARKS:

111 24 1970

MISS. BD. OF  
WATER COMMISSIONERS

If well telescopes please sketch and show depths.

GROUND LEVEL

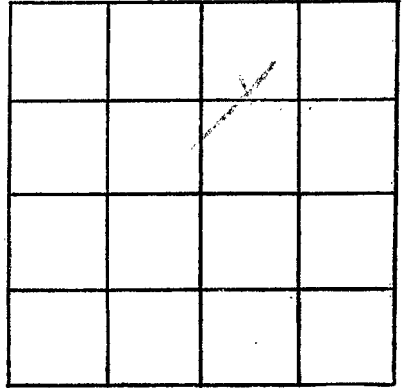

SECTION 32

Please indicate well location X.

ADDITIONAL INFORMATION

If more than one screen, show locations of each on sketch.