

PIKE  
E 93  
6-24-70

MISSISSIPPI  
BOARD OF WATER COMMISSIONERS  
416 North State Street  
Jackson, Mississippi 39201

CODED

WATER WELL DRILLERS LOG

24 Jul 1970 J.T. Campbell & Son Pike  
date well completed firm name county well located

LANDOWNER:  
Cl and Owens  
Napaola  
(mailing address)

WELL LOCATION:  
sec. 35 T. 3 N R. 5 E  
8 miles East of Napaola  
(distance) (direction) (nearest town)

WELL PURPOSE: Home  
(home, irrigation, municipal, industrial)

- WELL COMPLETION DATA:
- (1) diameter (inches) 4
  - (2) total depth (feet) 144
  - (3) static water level (feet) 85 below top of ground
  - (4) casing (material) PL (depth) 138  
(size) If telescope see back.
  - (5) screen (length) 6 (depth to top) 138  
(size) 4 (material) PL
  - (6) pump (HP) 1/2 (yield gpm) 8  
(type power) Elect
  - (7) electric log (yes or no)
  - (organization running log)
  - (8) how well bottom plugged wood

description of formations encountered	from	to
clay	0	15
red shale	15	20
cherty rock	20	60
red rock	60	85
shale	85	100
sand	100	144


CODED

AUG 7 1970

DRILLERS REMARKS:

If well telescopes please sketch and show depths.

GROUND LEVEL

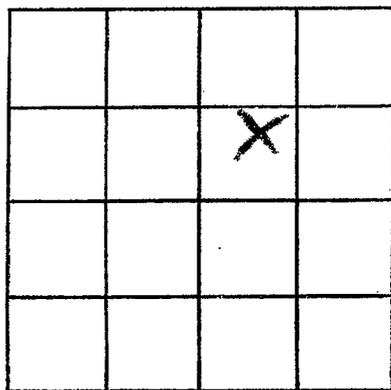

SECTION 25

Please indicate well location X.

ADDITIONAL INFORMATION

If more than one screen,  
show locations of each on sketch.