

PIKE
E 94
9-23-70

MISSISSIPPI
BOARD OF WATER COMMISSIONERS
416 North State Street
Jackson, Mississippi 39201

CODED

WATER WELL DRILLERS LOG

9-23 1970
date well completed

Fitzgerald Well Drilling
firm name

Pike
county well located

LANDOWNER:

Percy Pittman

R.R. Farnsworth, Miss.
(mailing address)

description of formations encountered

from to

Red clay 5 20
Red sand 20 80
Coarse sand & gravel 80 118

WELL LOCATION:

sec. 32 T 3 N R 8 E
2 miles E of Farnsworth
(distance) (direction) (nearest town)

WELL PURPOSE: Home
(home, irrigation, municipal, industrial)

WELL COMPLETION DATA:

- (1) diameter (inches) 4
- (2) total depth (feet) 118
- (3) static water level (feet) 80 below top of ground.
- (4) casing Plastic 112 (material) (depth)
4 (size) If telescope see back.
- (5) screen 6 112 (length) (depth to top)
4 (size) Plastic (material)
- (6) pump 3/4 6 (HP) (yield gpm)
C/C (type power)
- (7) electric log No (yes or no)

(organization running log)

(8) how well bottom plugged Wood peg

CODED


OCT 16 1970

DRILLERS REMARKS:

MISS. RD. OF
WATER COM. BY

If well telescopes please sketch and show depths.

GROUND LEVEL

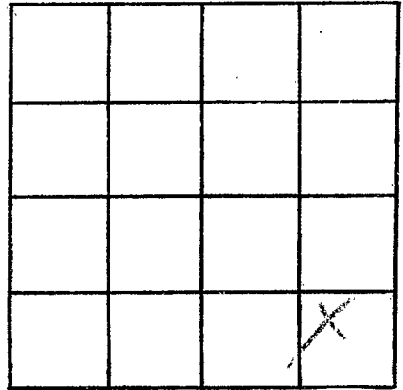

SECTION 32

Please indicate well location X.

ADDITIONAL INFORMATION

If more than one screen,
show locations of each on sketch.