

PIKE
E 95
11-6-70

MISSISSIPPI
BOARD OF WATER COMMISSIONERS
416 North State Street
Jackson, Mississippi 39201

CODED

WATER WELL DRILLERS LOG

11-6 1970 Fitzgerald Well Co Peke
date well completed firm name county well located

LANDOWNER:
James Johnson
R.R. Magnolia
(mailing address)

description of formations encountered	from	to
red clay	0	20
red sand	20	60
red gravel	60	90
red sand	90	110
concrete & gravel	110	125

WELL LOCATION:
sec 32 T 3 N R 8 E
S W
2 miles E of Peke
(distance) (direction) (nearest town)

WELL PURPOSE: Home
(home, irrigation, municipal, industrial)

- WELL COMPLETION DATA:
- (1) diameter (inches) 4
 - (2) total depth (feet) 125
 - (3) static water level (feet) 80 below top of ground.
 - (4) casing Plastic, 117,
(material) (depth)
4 if telescope see back.
(size)
 - (5) screen 8, 117
(length) (depth to top)
4, Plastic
(size) (material)
 - (6) pump 1, 6
(HP) (yield gpm)
Electric
(type power)
 - (7) electric log no
(yes or no)
 - (8) how well bottom plugged mostly

CODED


NOV 9 - 1970

DRILLERS REMARKS:

MISS. BD. OF
WATER COMMISSIONERS

If well telescopes please sketch and show depths.

GROUND LEVEL

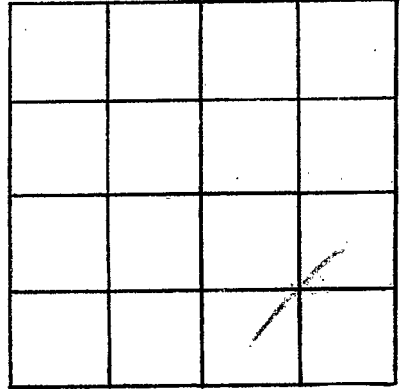

SECTION 32

Please indicate well location X.

ADDITIONAL INFORMATION

If more than one screen, show locations of each on sketch.