

PIKE
E 96
10-28-70

MISSISSIPPI
BOARD OF WATER COMMISSIONERS
416 North State Street
Jackson, Mississippi 39201

CODED

WATERWELL DRILLERS LOG

oct 28 1970 date well completed
chester keener firm name
pike county well located

LANDOWNER: Frank Melvin
Atch
M. Lamb
(mailing address)

WELL LOCATION:
sec 35 T 3 N R 8 E
4 miles E of Forward
(distance) (direction) (nearest town)

WELL PURPOSE: Home
(home, irrigation, municipal, industrial)

- WELL COMPLETION DATA:
- (1) diameter (inches) 4"
 - (2) total depth (feet) 130
 - (3) static water level (feet) 94 below top of ground.
 - (4) casing Plastic Ballast (material) (depth)
 - (5) screen 6' 1 1/4" (length) (depth to top)
4" Plastic (size) (material)
 - (6) pump 1/2 HP (HP) 12 (yield gpm)
Electric (type power)
 - (7) electric log NO (yes or no)

(organization running log)

(8) how well bottom plugged
wooden plug

DRILLERS REMARKS:
new haul


description of formations encountered	from	to
clay	0	10
sand	10	30
chalk & gravel	30	40
sand	40	60
sand & gravel	60	70
sand	70	80
sand & gravel	80	100
chalk & sand	100	102
sand & gravel	102	130

CODED

NOV 16 1970

If well telescopes please sketch and show depths.

GROUND LEVEL

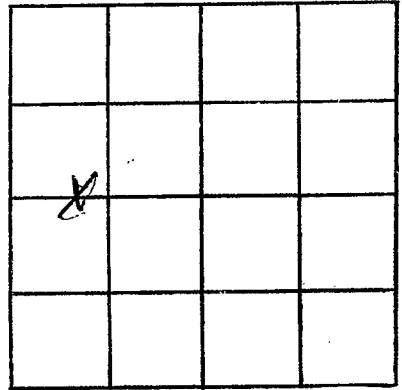

SECTION 35

Please indicate well location X.

ADDITIONAL INFORMATION

If more than one screen, show locations of each on sketch.