

MISSISSIPPI
BOARD OF WATER COMMISSIONERS
416 North State Street
Jackson, Mississippi 39201

CODED

WATER WELL DRILLERS LOG

PIKE
E 97
12-2-70

Dec 2 1970 date well completed
Chester Keener firm name
Pike county well located

LANDOWNER: Billy Van Noy
H-2 McLamb
(mailing address)

description of formations encountered	from	to
clay	0	25
cherty sand	25	60
sand & gravel	60	97

WELL LOCATION:
sec. 4 T 3 N R. 5 E
3/4 miles E of McLamb
(distance) (direction) (nearest town)

WELL PURPOSE: farm - water
(home, irrigation, municipal, industrial)

- WELL COMPLETION DATA:
- (1) diameter (inches) 4 1/2
 - (2) total depth (feet) 97
 - (3) static water level (feet) 59 below top of ground
 - (4) casing Plastic Bottom (material) (depth)
 - (5) screen 10' 77" (length) (depth to top)
4" Plastic (size) (material)
 - (6) pump 1/2 HP Sub-Pump (HP) (yield gpm)
1/2 HP elect. (type power)
 - (7) electric log no (yes or no)

CODED

(organization running log)


(8) how well bottom plugged
completely

FFR 5 1971

DRILLERS REMARKS:
old till well not sufficient

If well telescopes please sketch and show depths.

GROUND LEVEL

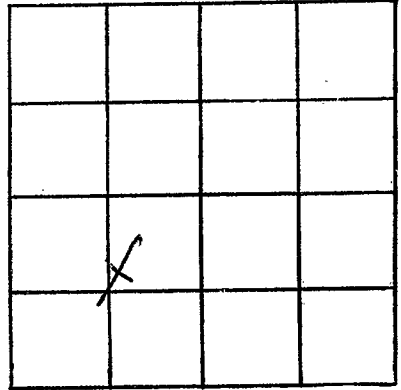

SECTION 4

Please indicate well location X.

ADDITIONAL INFORMATION

If more than one screen, show locations of each on sketch.