

MISSISSIPPI
BOARD OF WATER COMMISSIONERS
416 North State Street
Jackson, Mississippi 39201

CODED

WATER WELL DRILLERS LOG

PIKE
E 98
12-23-70

Dec 23 1970 Chesters Reeves Pike -
date well completed firm name county well located

LANDOWNER: Harrison
Warriner
At-1, M. Lamb
(mailing address)

WELL LOCATION:
sec. 32 T 3 N R. 8 E
1 1/2 miles SE of Ferwood
(distance) (direction) (nearest town)

WELL PURPOSE: Home
(home, irrigation, municipal, industrial)

WELL COMPLETION DATA:
(1) diameter (inches) 4"
(2) total depth (feet) 105
(3) static water level (feet) 75 below top of ground.
(4) casing Plast Ballon
(material) (depth)
(size) if telescope see back.
(5) screen 6' 99'
(length) (depth to top)
4" Plast
(size) (material)
(6) pump 1/2 12
(HP) (yield gpm)
Elect
(type power)
(7) electric log NO
(yes or no)
(organization running log)

(8) how well bottom plugged wooden plug

DRILLERS REMARKS: old
rod pump well bad

| description of formations encountered | from | to |
|---------------------------------------|------|-----|
| clay | 0 | 8 |
| chalk | 8 | 20 |
| Sandy chalk | 20 | 40 |
| chalk | 40 | 70 |
| Sand | 70 | 80 |
| Sand with gravel | 80 | 105 |


CODED

FEB 9 1971

MISS. DE. OF
WATER COMM.

If well telescopes please sketch and show depths.

GROUND LEVEL

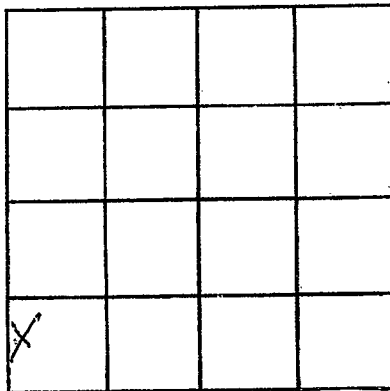

SECTION 32

Please indicate well location X.

ADDITIONAL INFORMATION

If more than one screen, show locations of each on sketch.