

PIKE
E99
1-21-71

MISSISSIPPI
BOARD OF WATER COMMISSIONERS
416 North State Street
Jackson, Mississippi 39201

CODED

WATER WELL DRILLERS LOG

1-21-71 date well completed 1971 *Fitzgerald* firm name *Pike* county well located

LANDOWNER: *Deane Simmons*
R.R. McComb, Miss.
(mailing address)

description of formations encountered	from	to
<i>Real clay</i>	0	20
<i>Real sand</i>	20	90
<i>Real gravel</i>	90	110
<i>Real sand</i>	110	135
<i>Coarse sand & gravel</i>	145	159

WELL LOCATION:
sec. 23 T. 3 S. R. 8 E
5 miles E of McComb
(distance) (direction) (nearest town)

WELL PURPOSE: Home
(home, irrigation, municipal, industrial)

- WELL COMPLETION DATA:
- (1) diameter (inches) 4
 - (2) total depth (feet) 159
 - (3) static water level (feet) 110 below above top of ground.
 - (4) casing schedule 40 (material) 153 (depth)
4 if telescope see back. (size)
 - (5) screen 6 (length) 153 (depth to top)
4 (size) plastic (material)
 - (6) pump 1/2 (HP) 8 (yield gpm)
ole (type power)
 - (7) electric log no (yes or no)
(organization running log)
 - (8) how well bottom plugged wool m

CODED


FEB 11 1971

MISS. BD. OF
WATER COMMISSIONERS

DRILLERS REMARKS:

If well telescopes please sketch and show depths.

GROUND LEVEL

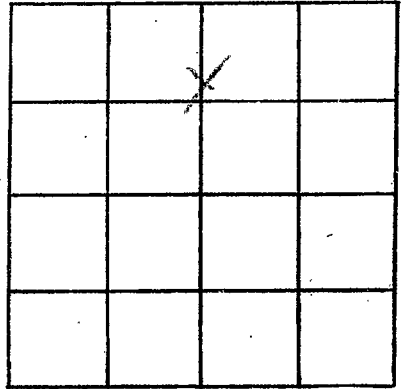

SECTION 22

Please indicate well location X.

ADDITIONAL INFORMATION

If more than one screen, show locations of each on sketch.