

PIKE
E 100
7-4-69

MISSISSIPPI
BOARD OF WATER COMMISSIONERS
416 North State Street
Jackson, Mississippi 39201

CODED

WATER WELL DRILLERS LOG

45 July 1969
date well completed

J.T. Carney & Son
firm name

Pike
county well located

LANDOWNER:
Jessie Varnado
Mapolis
(mailing address)

WELL LOCATION:
sec 32 T 3 N R 8 E
3 miles West of Farmers
(distance) (direction) (nearest town)

WELL PURPOSE: Home
(home, irrigation, municipal, industrial)

description of formations encountered	from	to
Clay	0	35
3rd chalk	35	50
Chalk	50	65
Chalk 2nd	65	85
2nd	85	100

WELL COMPLETION DATA:

(1) diameter (inches) 4 1/2"

(2) total depth (feet) 100

(3) static water level (feet) 65 below above top of ground.

(4) casing Plastic, 100
(material) (depth)
(size) If telescope see back.

(5) screen 6', 94
(length) (depth to top)
1/2", Plastic
(size) (material)

(6) pump 1/2, 8
(HP) (yield gpm)
Electric
(type power)

(7) electric log _____
(yes or no)


(organization running log)

(8) how well bottom plugged. wood

CODED


AUG 25 1969

DRILLERS REMARKS:

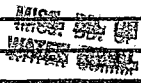

If well telescopes please sketch and show depths.

GROUND LEVEL

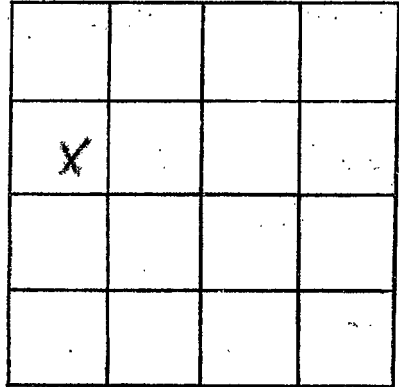

SECTION 32

Please indicate well location X.

ADDITIONAL INFORMATION

If more than one screen,
show locations of each on sketch.