

MISSISSIPPI
BOARD OF WATER COMMISSIONERS
416 North State Street
Jackson, Mississippi 39201

CODED

WATER WELL DRILLERS LOG

PIKE
E 101
8-16-69

Aug 16 1969 *Kerns Well Drilling Co* *Pike*
date well completed firm name county well located

LANDOWNER: *Engene Varnado - RFD, McComb*
(mailing address)

WELL LOCATION:
sec *35* T *3* N R *4* E
3 1/2 miles *E* of *Farmwood*
(distance) (direction) (nearest town)

WELL PURPOSE: *Home*
(home, irrigation, municipal, industrial)

- WELL COMPLETION DATA:
- (1) diameter (inches) 4"
 - (2) total depth (feet) 131
 - (3) static water level (feet) 14 below top of ground. above
 - (4) casing Plastic Bottom
(material) (depth)
 - (5) screen 6' 125'
(length) (depth to top)
4" Plastic
(size) (material)
 - (6) pump 1/2 HP 12
(HP) (yield gpm)
Elect.
(type power)
 - (7) electric log NO
(yes or no)
 - (8) how well bottom plugged
wooden plug

description of formations encountered	from	to
Red clay	0	18
Red chalk	18	38
Red sand	38	72
Gravel	72	81
Pink chalk	81	84
Gravel & chalk	84	112
White chalk	102	112
fine sand	112	125
Pea gravel & sand	125	131

CODED


SEP 29 1969

MISS. BD. OF
WATER COMMISSIONERS

DRILLERS REMARKS:
New House -

If well telescopes please sketch and show depths.

GROUND LEVEL

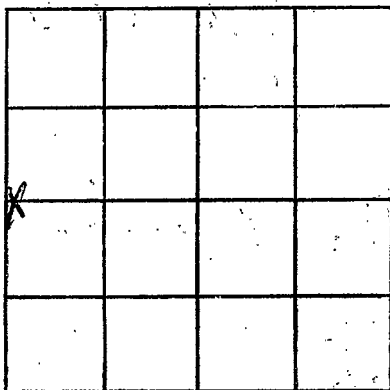

SECTION 35

Please indicate well location X.

ADDITIONAL INFORMATION

If more than one screen,
show locations of each on sketch.