

PIKE
E 102
8-18-69

MISSISSIPPI
BOARD OF WATER COMMISSIONERS
416 North State Street
Jackson, Mississippi 39201

CODED

WATER WELL DRILLERS LOG

August 18 1969 *Reverend Drumpke* *Pike*
date well completed firm name county well located

LANDOWNER: *Wm. Samuel Lee Allen*
Rt. 2, McComb
(mailing address)

description of formations encountered	from	to
<i>Red clay</i>	<i>0</i>	<i>19</i>
<i>Red sand</i>	<i>19</i>	<i>92</i>
<i>Gravelly chert</i>	<i>92</i>	<i>115</i>
<i>Small gravel</i>	<i>115</i>	<i>120</i>

WELL LOCATION:
sec. *14* T. *3* N R. *8* E
4 miles *East* of *McComb*
(distance) (direction) (nearest town)

WELL PURPOSE: *Home*
(home, irrigation, municipal, industrial)

WELL COMPLETION DATA:

- (1) diameter (inches) *2"*
- (2) total depth (feet) *120*
- (3) static water level (feet) *90* below top of ground.
- (4) casing *Steel bottom*
(material) (depth)
6' If telescope see back.
(size)
- (5) screen *1 1/4'* *1 1/4'*
(length) (depth to top)
1 1/4" *Plastic*
(size) (material)
- (6) pump *Red Drum*
(HP) (yield gpm)
(type power)
- (7) electric log *No*
(yes or no)
(organization running log)
- (8) how well bottom plugged *✓*

CODED


AUG 25 1969

MISS. Bd. of WATER COMMISSIONERS

DRILLERS REMARKS:

If well telescopes please sketch and show depths.

GROUND LEVEL

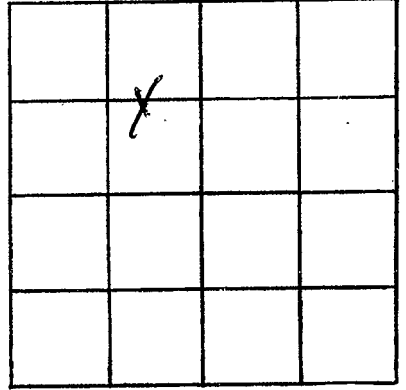

SECTION 14

Please indicate well location X.

ADDITIONAL INFORMATION

If more than one screen, show locations of each on sketch.